


Section 32 Township 33 Range 3-E

Well No. #1 Hower "B"

Company Wakefield

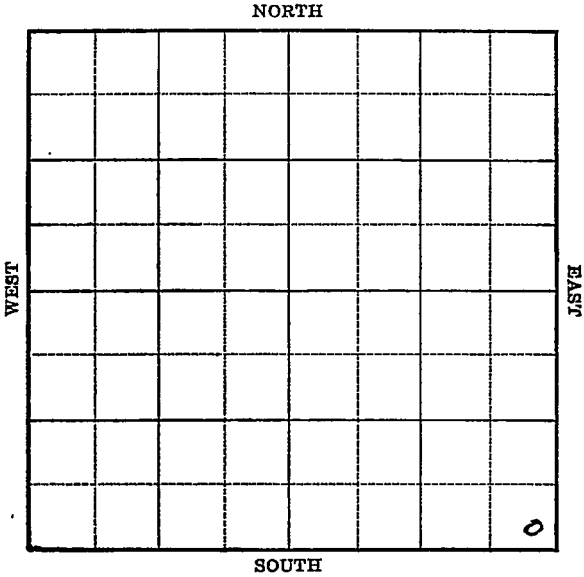

KANSAS


Cowley

Sec. 32 Twp. 33 R. 3-EWell No. #1 Hower "B" FarmWakefield Company

\_\_\_\_\_ Ft. from N. Line

330 Ft. from S. Line330 Ft. from E. Line

\_\_\_\_\_ Ft. from W. Line

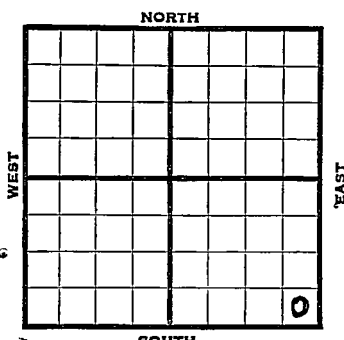

Elev. 1107'.

1938	REPORT
11/16	Spud.
11/25	20" - 73'. Drlg. 125'.
12/2	15" - 138'. Drlg. 955'.
12/9	S.D. 1345'.
12/15	" "
12/23	12" - 1343'. Drlg. 1700'.
12/30	10" - 1800'. 8" - 2035'.
	Stalnaker 2193'. Drlg. 2255'.
1939	
1/6	T. D. 2330'. Rep. Rig.
1/13	Drlg. 2485'.
1/20	Drlg. 2890'.
1/27	5" - 3304'. Est. 1/2 M gas 3304'
	T. D. 3306'.
2/3	Bart. 3305'. T. D. <del>3336</del> <sup>3332</sup> '.
	Est. 1 M gas. S. O.
2/10	T. D. 3332' (Corrected)
	Flow 10 oil per day.
	Shot 10 qts. 3310-25'. C. O.
	<b>OVER</b>

1939

2/15 5" - 3304'

Bart. 3305'

T.D. 3332' (Corrected)

Shot 15 qts.

Minimum well.

15 barrels.

**COMPLETED**

Map No. / Sec. 32 Twp. 33 R. 3E

Well No. 1 Hower "B"

Wakefield

Company

Contractor

FIRST REPORT

SE/C

\_\_\_\_\_ Ft. from N. Line

330 Ft. from S. Line

330 Ft. from E. Line

\_\_\_\_\_ Ft. from W. Line

SECTION PLAT

			0

Location \_\_\_\_\_

Rig up \_\_\_\_\_

Drilling and Remarks:

Spud

RECORD

Cased \_\_\_\_\_ in., \_\_\_\_\_ ft.

Sand \_\_\_\_\_

Gas \_\_\_\_\_

Oil \_\_\_\_\_

Total Depth \_\_\_\_\_

PRODUCTION

1st 24 hrs. Nat. \_\_\_\_\_

1st 24 hrs. after shot \_\_\_\_\_

Gas \_\_\_\_\_ Cu. Ft.

Dry Hole \_\_\_\_\_

Abandoned \_\_\_\_\_

Date

NOV 16 1938 19 H. D. Hatfield Scout

