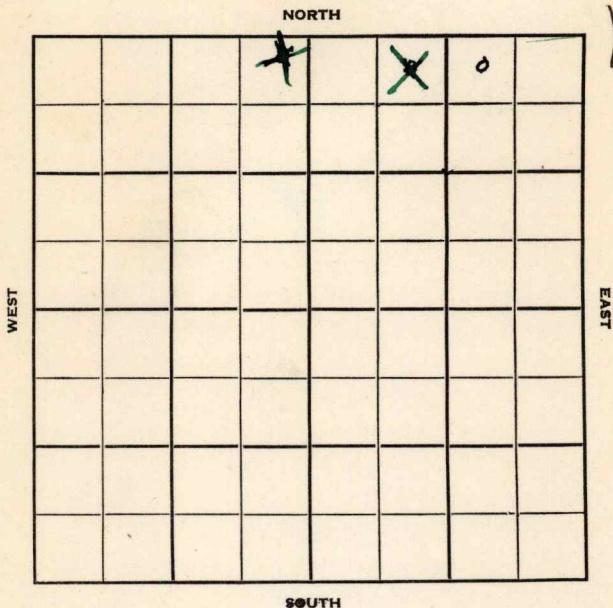


Section 2 Township 16 Range 4WWell No. 2 LockstromCompany Derby Oil

Saline


KANSAS

Sec. 2 Twp. 16 R. 4 W ✓Well No. # 2 Lockstrom FarmDerby Oil CompanyCarey Drilling Contractor

Smolan Pool

330 Ft. from N. Line Ft. from S. Line990 Ft. from E. Line Ft. from W. Line

NW NE NE

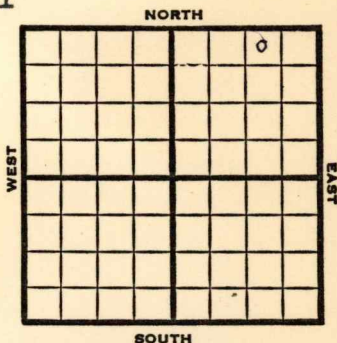

1951

Elev. 1323'

REPORT

7/18

Cellar & Pits

9/19

Spud 7-22-51

Oil well TD 3605' 8" @ 330'

Maq. dol. 3429' Viola 3496'

Simp. 3583-3605' 5" @ 3491'

TD 3605' 5/3449-53 16/3448-55

FU 535' fluid 13 hr. (100' oil)

P/1 BO 3½ BW 4 hr. FU 655' fluid

16 hr. (210' oil) 250 A

FU 1950' oil, 583' water 12 hr.

S/23 BFPH 10% water SP 3446'

16/3430-32 FU 1800' oil 30' wtr.

16 hr. 240 A FU 2180' oil, 350'

water, 13 hr. S/67½ BF 3 hr.

10% water. FU 2120' oil, 70' wtr.

16½ hr.

Comp. 505 BOPD 10% water

COMPLETED

County **Saline** State **Kansas**

Sec. 2 (Bk. 16 (Sur. 4W Map No.

Operator Derby Oil

Well No. **2** Farm **Lockstrom**

Elev.	Location	NW	NE	NE

330 Ft. From N Line NE

990 Ft. From **E** Line Quarter

1st. Report JUL 18 1951

Completion

Remarks

Carey Drlg. - Contr.

Spudding Date _____

Drlg. Data Smolan Pool

Cellar & pits

J. E. TYRA

County Saline State KansasSec. 2 (Blk. Twp.) 16 (Sur. Rge.) 4W Map No.Operator Derby OilWell No. 2 Farm LockstromElev. 1323 Location NW NE NE

330 Ft. From N Line NE990 Ft. From E Line Quarter

1st. Report

SFP 1 9 1951

Completion

Remarks Smolan PoolCarey Drlg. - Contr.Spudding Date 7-22-51Drlg. Data Oil well TD 36058" @ 330 Maq. dol. 3429 Viola 3496Simp. 3583-3605 5" @ 3491 TD 36055/ 3449-53 16/ 3448-55 FU 535' fluid13 hr. (100' oil) P/ 1 bo 3 $\frac{1}{2}$ bw 4 hr.FU 655' fluid 16 hr. (210' oil)250 A FU 1950' oil 583' water 12 hr.S/ 23 bfph 10% water SP 344616/ 3430-32 FU 1800' oil 30' water 16 hr250 A FU 2180' oil 350' water 13 hr.S/ 67 $\frac{1}{2}$ bf 3 hr. 10% water FU 2120' oil470' water 16 $\frac{1}{2}$ hr. Comp. 505 bopd 10%

J. E. TYRA