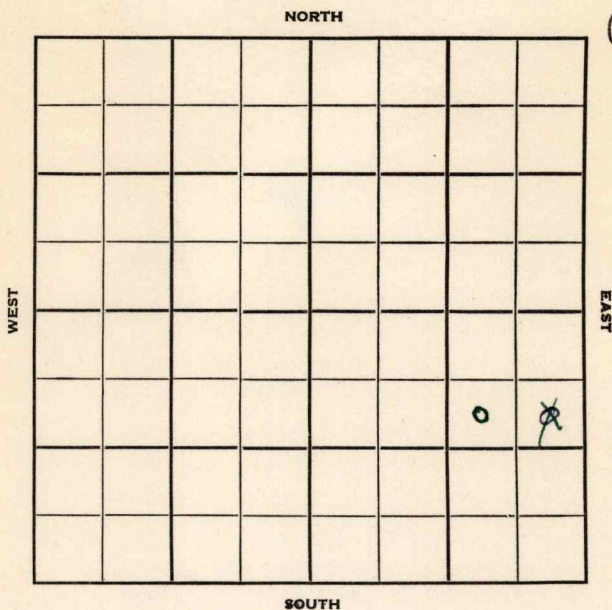


Section 2 Township 16 Range 4WWell No. #2 SandbergCompany Jones, Shelburne & Farmer

Saline

Sec. 2 Twp. 16 R. 4W

Well No. #2 Sandberg Farm

Jones, Shelburne & Farmer Company

Honaker Contractor

Smolan

990 Ft. from N. Line


Ft. from S. Line

990
330

Ft. from E. Line

Ft. from W. Line

SW NE SE
SE NE SE

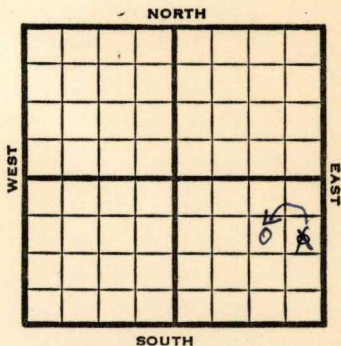

1951

Elev. 1328'

REPORT

11/14
1952
2/6

Location

Spud 11-23-51

Oil Well TD 3443

8" @ 335

Miss 2924

Kh. 3231

Maw. 3380

Dol. 3441

TD 3433 5" @ 3441 CO to 3443

S/ $4\frac{1}{2}$ bfph $3\frac{1}{2}$ was wtr.

Comp. 34 bopd 84% wtr.

COMPLETED

J. E. TYRA

Map No. _____ Sec. 2 Twp. 16 R. 4WWell No. 2 SandbergJones, Shelborne & Farmer CompanyCONNECTION

Contractor _____

SW NE SE

SECTION PLAT

990 Ft. from N. Line

_____ Ft. from S. Line

990 Ft. from E. Line

_____ Ft. from W. Line

			6

Saline County

RECORD

Location _____

Cased _____ in., _____ ft.

Rig up _____

Sand _____

Drilling and Remarks:

Gas _____

Oil _____

Total Depth _____

Reported

SE NE SE

PRODUCTION

1st 24 hrs. Nat. _____

1st 24 hrs. after shot _____

Gas _____ Cu. Ft.

Dry Hole _____

Abandoned _____

Date

NOV 21 1951 19J. E. TYRA

Scout

