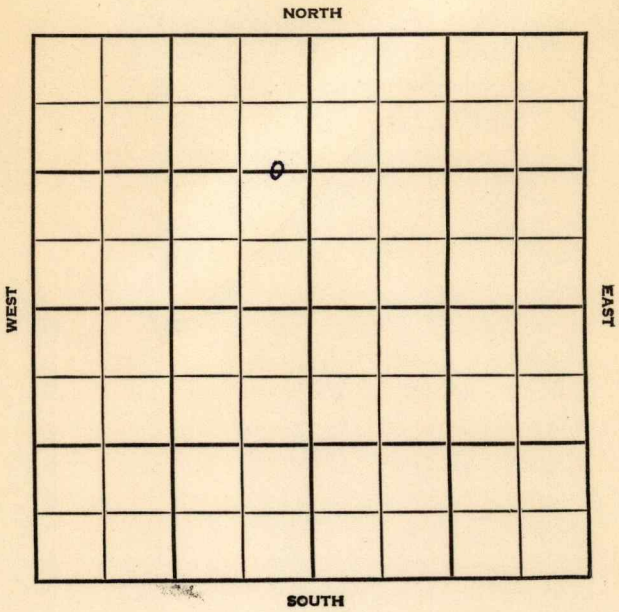


Section 2 Township 16 Range 4WWell No. #3 CarlsonCompany ElDorado Ref.

Saline

KANSAS

SEC.	TWP.	R.
2	16	4 W

WELL NO.

3 Carlson

FARM

COMPANY

Eldorado Ref.

CONTRACTOR

Lewis Drlg.

Smolan Pool

1320


Ft. from N. Line

Ft. from S. Line

330

Ft. from E. Line

Ft. from W. Line

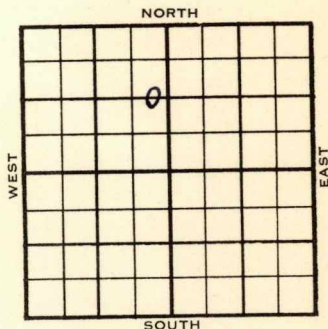C E $\frac{1}{2}$ E $\frac{1}{2}$ NW

1954

ELEVATION

1330'

REPORT

12/29

Spud 12-24-54
8" @ 397 Drlg.

1955

1/12

Spud 12-24-54

D & A

TD 3447'

8" @ 397'

Maq. 3439'

DST 3439'-47' opn 1 hr, rec 180' fluid
top 30' soc 270#

TD 3447'

D & A

ABANDONED

County Saline State KansasSec. 2 (Blk. Twp.) 16 (Sur. Rge.) 4W Map No.Operator Eldorado Ref.Well No. 3 Farm CarlsonElev. Location C E $\frac{1}{2}$ E $\frac{1}{2}$ NW1320 Ft. From N Line NW330 Ft. From E Line Quarter1st. Report DEC 29 1954

Completion

Remarks

Lewis Drlg. - Contr.Spudding Date 12-24-54Drlg. Data Smolan Pool8" @ 397 drlg.

FABEN GILSTRAP

County Saline State KansasSec. 2 (Blk.
Twp.) 16 (Sur.
Rge.) 4W Map No.Operator Eldorado Ref.Well No. 3 Farm CarlsonElev. 1330 Location C E $\frac{1}{2}$ E $\frac{1}{2}$ NW1320 Ft. From N Line NW330 Ft. From E Line Quarter1st. ReportCompletion JAN 1 2 1955Remarks Smolan PoolLewis Drlg. - Contr.Spudding Date 12-24-54Drlg. Data D & A TD 34478" @ 397 Maq. 3439 DST 3439-47open 1 hr. Rec. 180' fluid top 30' soc270# TD 3447D & A

FABEN GILSTRAP