


Section 2 Township 16 Range 4W

Well No. #3 Sandberg

Company Jones, Shelburne & Farmer

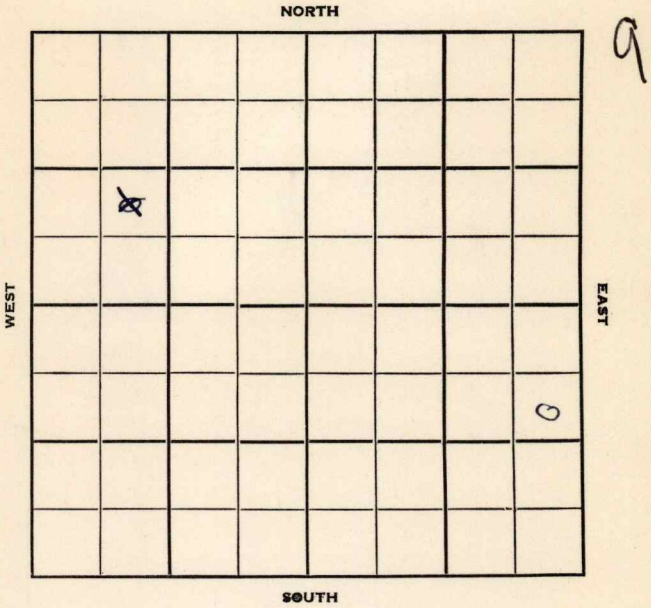

Saline

KANSAS

Sec. 2 Twp. 16 R. 4W

Well No. #3 Sandberg Farm

Jones, Shelburne & Farmer Company

Shields Contractor


990 Ft. from N. Line

\_\_\_\_\_ Ft. from S. Line

330 Ft. from E. Line

\_\_\_\_\_ Ft. from W. Line

SE NE SE

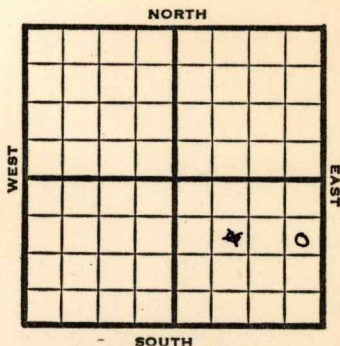

1952

Elev. 1323' REPORT

3/26

Spud 3-23-52  
8" @ 339'

Drlg. 370'

4/1

Drlg. 2825'

4/9

Miss 2922 KH 3225 Mq Sh 3375  
Mq Dol 3438

DST 3438-42 18 mins 5' m 110#

DST 3440-42 1/2 hr. 3'm 160#

TD 3442 5" @ 3439 WOCT

4/23

RTD 3438' 5" @ 3435' Cor.  
DP CO to 3438' POP

4/30

NR

5/7

"

5/14

"

5/21

"

5/28

"

6/11

"

6/18

Spud 3-23-52  
Oil Well TD 3438  
8" @ 339 Miss 2922 Kh 3225  
Maq sh 3375 Maq. dol. 3438  
DST 3434-38 opn 18 min. Rec. 5' mud  
DST 3440-42 opn 1/2 hr. Rec. 3' mud  
TD 3438 5" @ 3435 CO to 3438  
Comp. 149 bopd 2% wtr.

COMPLETED



