


DX 78-1

Section 2 Township 16 Range 14W

Well No. 5 Lockstrom

Company Derby Oil

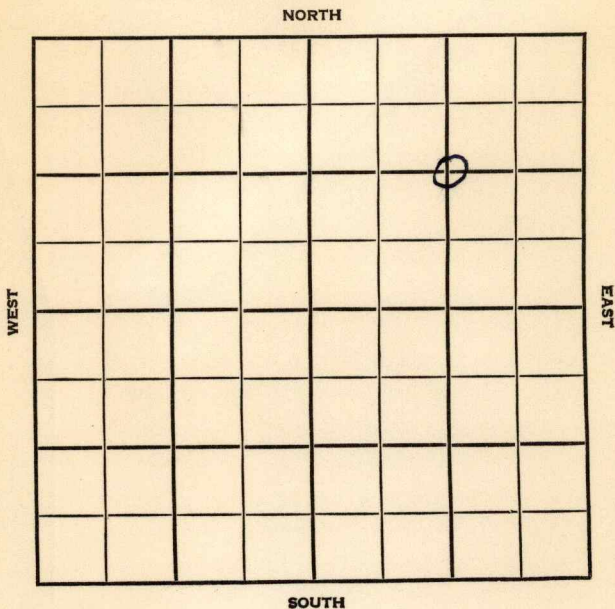

Saline KANSAS

SEC. 2	TWP. 16	R. 4W
------------------	-------------------	-----------------

WELL NO.

5 Lockstrom

FARM

COMPANY

Derby Oil

CONTRACTOR

Shields

Smolan Pool


1320 Ft. from N. Line

Ft. from S. Line

1320 Ft. from E. Line


Ft. from W. Line

C NE/4

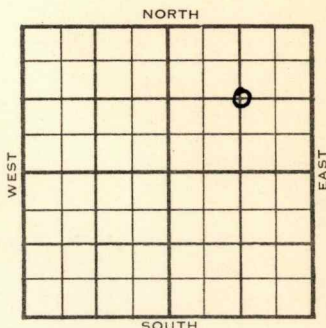

	ELEVATION	REPORT
1954	1325'	
6/23	Location	
6/30	"	
7/21	8" @ 345'	
	Drlg. 1855'	
8/25	Oil Well	
	TD 3436'	
	8" @ 345'	
	Maq. 3432'	
	TD 3435'	
	5" @ 3434'	
	CO to 3435'	
	DD 3436	
	S/1-3/4 boph 4 hrs., 1000A	
	S/13½ bo 1 hr.	
	S/10 bo 2nd hr.	
	S/9 bo 5rth hr.	
	P/104 bo 2% wtr. 13 hrs.	
	P/168 bo 24 hrs.	
	Miss 2922', Kh. 3200'	
	Comp. 223 bopd	

COMPLETED

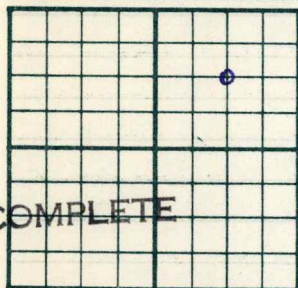County Saline State KansasSec. 2 (Blk.
Twp.) 16 (Sur.
Rge.) 4W Map No.Operator Derby OilWell No. 5 Farm LockstromElev. 1325 Location C NE/41320 Ft. From N Line NE1320 Ft. From E Line Quarter1st. ReportCompletion AUG 25 1954Remarks Smolan PoolShields - Contr.Spudding DateDrlg. Data Oil well TD 34368" @ 345 Maq. 3432 TD 3435 5" @ 3434CO to 3435 DD 3436 S/ 1 3/4 boph 4 hr.1000 A S/ 13 1/2 bo 1 hr. S/ 10 bo 2nd hr.S/ 9 bo 5th hr. P/ 104 bo 2% wtr. 13 hrP/ 168 bo 24 hr. Miss. 2922 Kh. 3200Comp. 223 bopd

FABEN GILSTRAP