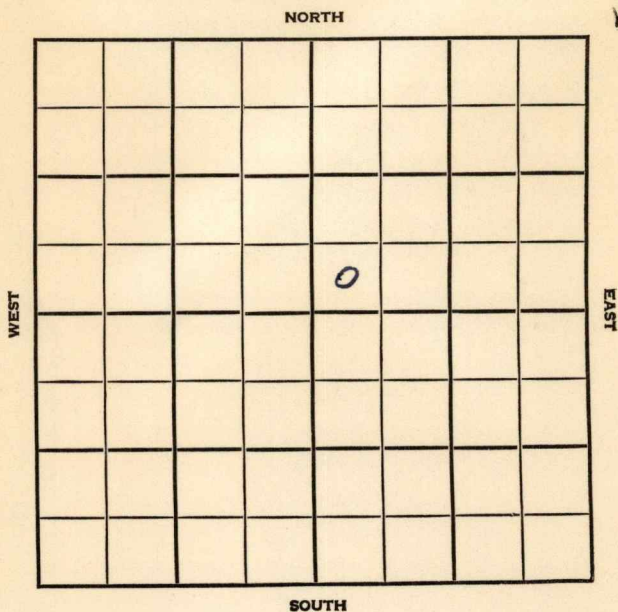


Section 2 Township 16 Range 4WWell No. 7 LockstromCompany Derby Oil Co.

Saline

KANSAS

SEC.	TWP.	R.
2	16	4W

WELL NO.

#7 Lockstrom

FARM

COMPANY

Derby Oil Co.

CONTRACTOR

Glen. W. Peel Tools.

Smolan Pool

NORTH

Ft. from N. Line


330

Ft. from S. Line

Ft. from E. Line

330

Ft. from W. Line

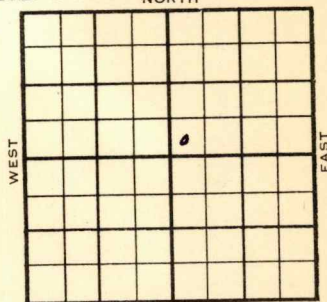

SW SW NE

SOUTH

	ELEVATION	REPORT
--	-----------	--------

1954

1337' DF

9/29

Spud 9-25-54

8" @ 412'

Drlg. 1385'

11/3

Spud 9-25-54

Oil Well

TD 3444'

8" @ 412'

Maq. 3443'

TD 3444'

5" @ 3443'

CO to 3444 2.15 boph 17 hr. 1000 A

5.81 bfph 4 hr. 5% Wtr. 2000 A

S/ 9.75 bf 1 hr. 16% Wtr.

Comp 224 bopd. 7% Wtr.

COMPLETED

County Saline State Kan.

Sec. 2 (Blk. Twp.) 16 (Sur. Rge.) 4W Map No.

Operator Derby Oil

Well No. 7 Farm Lockstrom

Elev.	1337	Location	SW SW NE
-------	------	----------	----------

330 Ft. From S Line NE

330 Ft. From W Line Quarter

1st. Report

Completion NOV 3 1954

Remarks Smolan Pool

Glenn Peel - Contr.

Spudding Date 9-25-54

Drlg. Data Oil well TD 3444

8" @ 412 Mag. 3443 TD 3444 5" @ **3443**

CO to 3444 2.15 boph 17 hr. 1000 A

5.81 bfph 4 hr. 5% wtr. 2000 A

S/ 9.75 bf 1 hr. 16% wtr.

Comp. 224 bopd 7% wtr.

FABEN GILSTRAP