


Section 11 Township 16 Range 4 W

Well No. # 1 Ryding

Company McPherson Oil Operating Co.

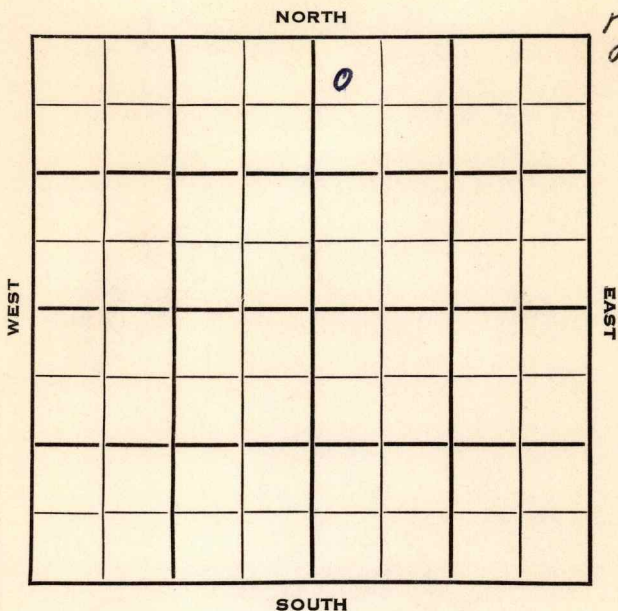

Sec. 11 Twp. 16 R. 4W

Well No. #1 Ryding Farm

McPherson Oil Operating Co Company

Ingling Contractor

Smolan Pool


330 Ft. from N. Line

_____ Ft. from S. Line

_____ Ft. from E. Line

330 Ft. from W. Line

NW NW NE

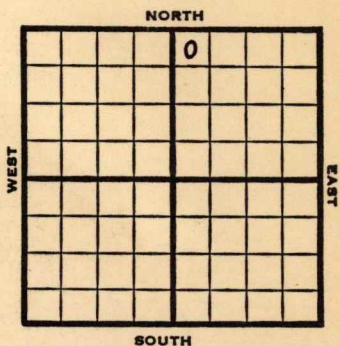

1953 **Elev. 1331'** REPORT

- 6/10 M I R
- 6/24 8" @ 378 w/360
Drlg. 1731
- 7/1 **Anhy 366**
Drlg 2803.
- 7/8 **Miss 2952, KH 3226, Mq sha 3371, Mq Dol 3444**
RTD 3444
5" @ 3443
- 7/15 DD 3440 TD
S/2 bw & 1/2 bo 2 hrs., 500A
- 7/29 9 bwph + little oil
- 8/5 No report
- 8/12 "
- 8/19 "
- 9/2 Sq. open hole CO 3440
A-frac split pipe sq.
- 9/9 N.R.
- 9/16 "
- 9/23 "

OVER

1953
9/30

Spud 6-15-53 D & A TD 3440
8" @ 378 Anhy 366 Miss 2952
Kh. 3226 Maq. sh. 3371 Maq. dol.
3437 5" @ 3437 TD 3438
DD 3440 S/2 BW $\frac{1}{2}$ BO 2 hr. 500 A
9 BWPH CO to 3440 A-frac.
P/10 BWPH D & A

ABANDONED

County Saline State Kansas

Sec. 11 (Blk. Twp.) 16 (Sur. Rge.) 4W Map No.

Operator McPherson Oil Operating Co.

Well No. 1 Farm Ryding

Elev. _____ Location NW NW NE

330 Ft. From N Line NE
330 Ft. From W Line Quarter

FIRST REPORT

1st. Report JUN 10 1953

Completion _____

Remarks _____

Inging - Contr.

Spudding Date _____

Drlg. Data Smolan Pool

M I R

