


Section 33 Township 33 Range 3 E

Well No. # 1 Aumann

Company Drillers Production

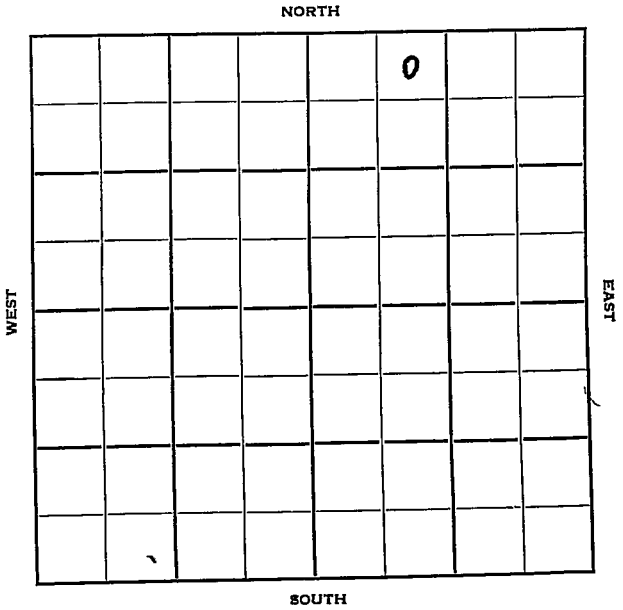

Cowley

KANSAS ✓

Sec. 33 Twp. 33 R. 3E

Well No. #1 Aumann Farm _____

Drillers Production Company _____

Rainbow Bend Pool Contractor _____


330 Ft. from N. Line

_____ Ft. from S. Line

_____ Ft. from E. Line

990 Ft. from W. Line

NE NW NE

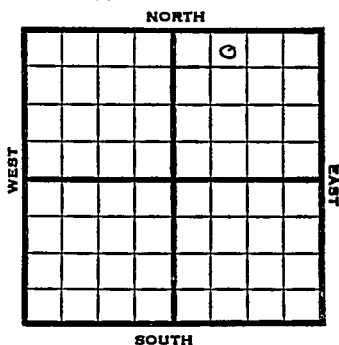

1952 Elev. 1109' REPORT

11/18 Spud 11-15-52
8" @ 101'

12/17 Spud 11-15-52
Oil Well
TD 3318
8" @ 101
Lans 2608, KC 2805, Marm 3003,
Bart 3297
TD 3318
5" @ 3300
CO to 3318 Hydro
Comp. F/50 bopd

COMPLETED

County Cowley State Kansas

Sec. 33 (Blk. 33) (Sur. 3E) Map No. _____
 (Twp.)

Operator Drillers Production

Well No. 1 Farm Aumann

Elev. 1109 Location NE NW NE

				0	

330 Ft. From N Line NE

990 Ft. From W Line Quarter

1st. Report _____

Completion DEC 17 1952

Remarks Rainbow Bend Pool

Spudding Date 11-15-52

Drig. Data Oil well TD 3318

8" @ 101 Lans. 2608 KC 2805 Marm. 3003

Bart. 3297 TD 3318 5" @ 3300

CO to 3318 Hydro.

Comp. F/ 50 bopd

J. G. McGEHEE