


Section 3 Township 16 Range 4W

Well No. 1 Bengston

Company Sheldon Bros.

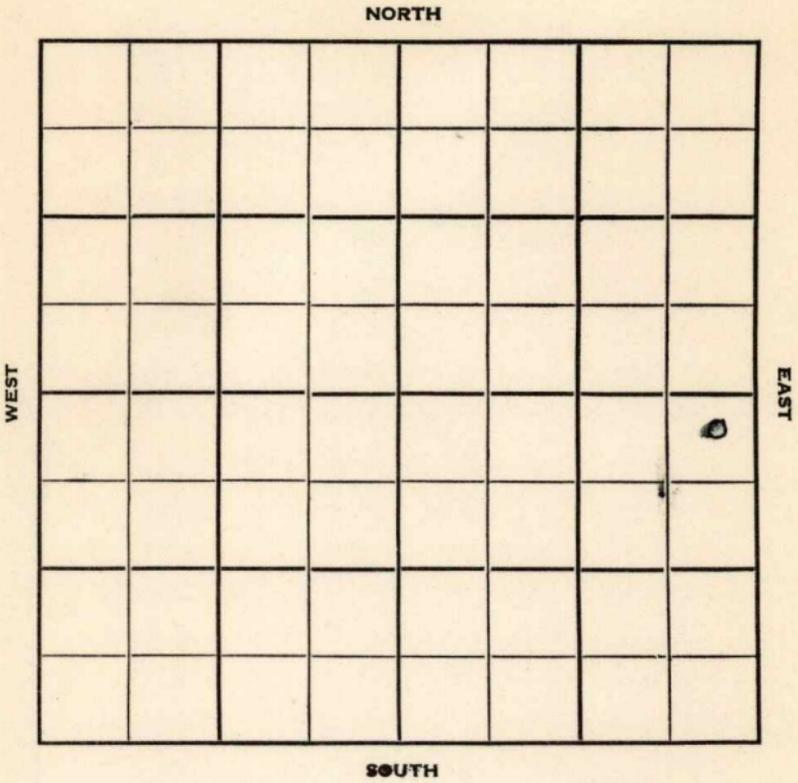

9

Saline

KANSAS

Sec. 3 Twp. 16 R. 4 W

Well No. # 1 Bengston Farm

Sheldon Bros. Company

Jackson Drlg. Contractor  
Wildcat


330 Ft. from N. Line

Ft. from S. Line

330 Ft. from E. Line

Ft. from W. Line

NE NE SE

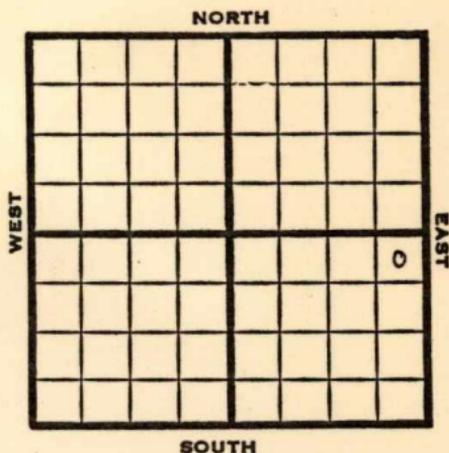

1951

Elev. 1326' REPORT

7/18

Location

8/15

Spud 7-28-51

D & A TD 3446' 8" @ 410'

Burgess 2944' Miss 2950' Kh. 3226'

Misenor 3392' Maq. sh. 3405'

Maq. dol. 3443'

DST 3444-46' TD open 45 min. rec 2040'  
mud & water.

D & A

**ABANDONED**


County **Saline** State **Kansas**

Sec. **3** (Blk.) (Twp.) **16** (Sur.) (Rge.) **4W** Map No.

Operator **Sheldon Bros.**

Well No. **1** Farm **Bengston**

Elev. Location **NE NE SE**

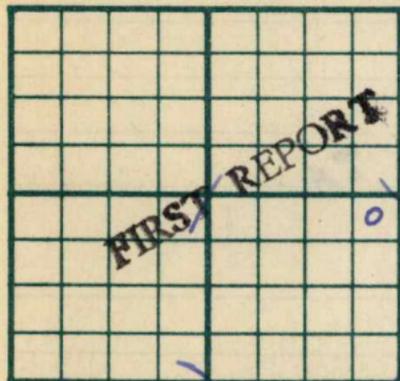

**330** Ft. From **N** Line **SE**

**330** Ft. From **E** Line Quarter

1st. Report **JUL 18 1951**

Completion

Remarks

Spudding Date

Drig. Data **Wildcat**

**Location**

County Saline State Kansas

Sec. 3 (Blk. Twp.) 16 (Sur. Rge.) 4W Map No.

Operator Sheldon Bros.

Well No. 1 Farm Bengston

Elev. 1326 Location NE NE SE



330 Ft. From N Line SE

330 Ft. From E Line Quarter

1st. Report

Completion AUG 15 1951

Remarks Wildcat

Jackson Drlg. - Contr.

Spudding Date 7-28-51

Drlg. Data D & A TD 3446

8" @ 410 Burgess 2944 Miss. 2950

Kh. 3226 Misenor 3392 Maq. sh. 3405

Maq. dol. 3443 DST 3444-46 TD

open 45 min. Rec. 2040' mud & water

D & A

J. E. TYRA