

KANSAS


Saline

FORM 51 5M BRIX

Section 10 Township 16 Range 4W

Well No. #1, Lindberg

Company Max Cohen

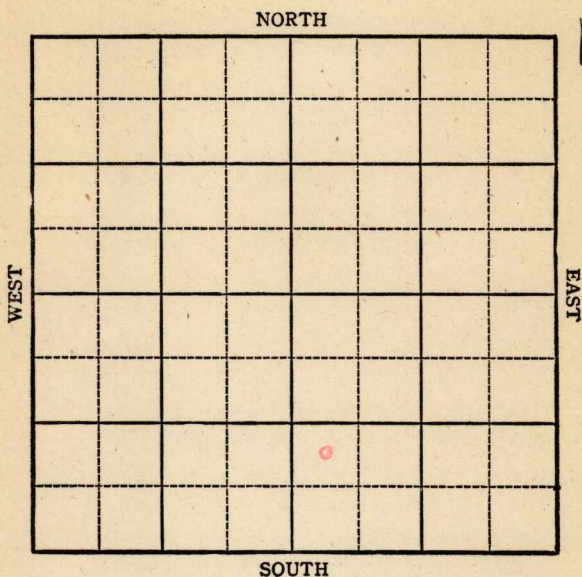

KANSAS

Saline

Sec. 10 Twp. 16 R. 4W


Well No. #1, Lindberg Farm
Max Cohen Company

 Ft. from N. Line

990 Ft. from S. Line

 Ft. from E. Line

330 Ft. from W. Line

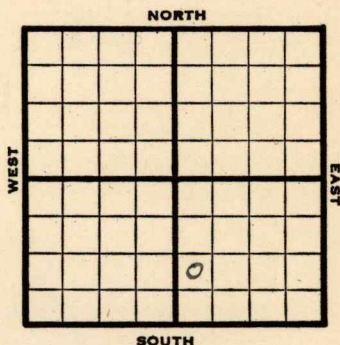

1944

R E P O R T

6/7

10" @ 449
Lans. 2410
Drlg. 2755

6/21

Misener 3472
Viola 3539
Simp 3644
T.D. 3686

ABANDONED

KANSAS

Pool Name WildcatMap No. 44 Sec. 10 Twp. 16 R. 4WWell No. 1 LindbergMax Cohen

Company

FIRST REPORT

Contractor

NW SW SE

SECTION PLAT

 Ft. from N. Line990 Ft. from S. Line Ft. from E. Line330 Ft. from W. Line

		o	

Saline County

RECORD

Location Cased in., ft.Rig up Sand

Drilling and Remarks:

Gas 10" - 449Oil Lans. 2410Total Depth 2755

PRODUCTION

1st 24 hrs. Nat. 1st 24 hrs. after shot Gas Cu. Ft.Dry Hole Abandoned

Date

JUN 7 1944 19S. J. LEWIS

Scout

Pool Name Wildcat

KANSAS


Map No. 44 Sec. 10 Twp. 16 R. 4WWell No. 1 LindbergMax Cohen

Company

ABANDONED
NW SW SE

Contractor

SECTION PLAT

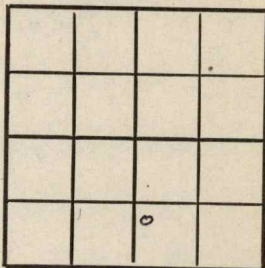

Ft. from N. Line

990 Ft. from S. Line

Ft. from E. Line

330 Ft. from W. LineSaline County

Location

Rig up

Drilling and Remarks:


RECORD

Cased _____ in., _____ ft.

Sand _____

Gas _____

Oil _____

Total Depth 3688

PRODUCTION

1st 24 hrs. Nat. _____

1st 24 hrs. after shot _____

Gas _____ Cu. Ft.

Dry Hole _____

Abandoned _____

Date

JUN 21 1944

19

S. J. LEWIS

Scout