



Sec. 11 Twp. 16 R. 4 W

Well No. # 1 Lagerstrom Farm

J-S-F Company

Shields Contractor


330 Ft. from N. Line

Ft. from S. Line

330 Ft. from E. Line

Ft. from W. Line

NE NE NW

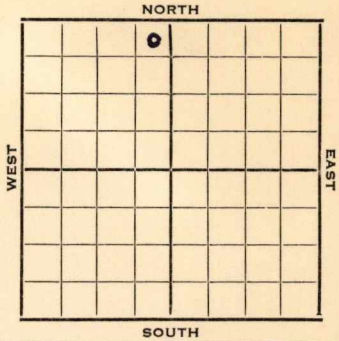

1952

Elev. 1341' REPORT

- 9/4 Spud 9-4-52
- 9/10 8" @ 367'
Drlg. 1400'
- 9/17 Ft. Riley 1420' Heeb 1860'
KC 2480' Miss 2925'
Drlg. 3151'
- 9/24 KH 3244' Mq sha 3392' Mq Dol 3455-56
RTD 5" @ 3454½
- 10/1 CO 3456' 35 gal O plus 5 gal WPH
250 A s/10 BO plus 1 BWPH
- 10/8 "
- 10/15 "
- 10/22 NR
- 10/29 "
- 11/5 "
- 11/12 Spud 9-4-52
Oil Well
TD 3456'
8" @ 367'
Ft. Riley 1420', Heeb. 1860',
KC 2480, Miss. 2925, Kh. 3244,
Maq. sh. 3392, Maq. dol. 3455
TD 3456'
5" @ 3454
CO to 3456, 35 go 5 gwph 250A
S/10 boph 1 bw
Comp. 90 bopd 9% wtr.

COMPLETED

County Saline State Kansas

Sec. 11 (Blk. Twp.) 16 (Sur. Rge.) 4W Map No.

Operator J-S-F

Well No. 1 Farm Lagerstrom

Elev. _____ Location NE NE NW

| | | | | | |
|--|--|---|--|--|--|
| | | 0 | | | |
| | | | | | |
| | | | | | |
| | | | | | |
| | | | | | |
| | | | | | |
| | | | | | |
| | | | | | |

FIRST REPORT

330 Ft. From N Line NW
330 Ft. From E Line Quarter

Ist. Report SEP 4 1952

Completion _____

Remarks _____

Shields - Contr.

Spudding Date 9-4-52

Drilg. Data _____

County Saline State Kansas
 Sec. 11 (Blk. 16) (Sur. 4W) Map No. _____
 Operator Jones, Shelburne & Farmer
 Well No. 1 Farm Lagerstrom
 Elev. 1341 Location NE NE NW

| | | | | | |
|--|--|---|--|--|--|
| | | | | | |
| | | 0 | | | |
| | | | | | |
| | | | | | |
| | | | | | |
| | | | | | |
| | | | | | |
| | | | | | |
| | | | | | |
| | | | | | |

330 Ft. From N Line NW
330 Ft. From E Line Quarter
 1st. Report _____
 Completion NOV 12 1952
 Remarks _____
Shields - Contr.
 Spudding Date 9-4-52

Drlg. Data Oil well TD 3456
8" @ 367 Ft. Riley 1420 Heeb. 1860
KC 2480 Miss. 2925 Kh. 3244
Maq. sh. 3392 Maq. dol. 3455 TD 3456
5" @ 3454 CO to 3456 35 go 5 gwph
250 A S/ 10 boph 1 bw
Comp. 90 bopd 9% wtr.

