


DX 78-1 Saline

KANSAS

Section 11 Township 16 Range 4W

Well No. #2 Lagerstrom

Company Jones, Shelburne & Farmer

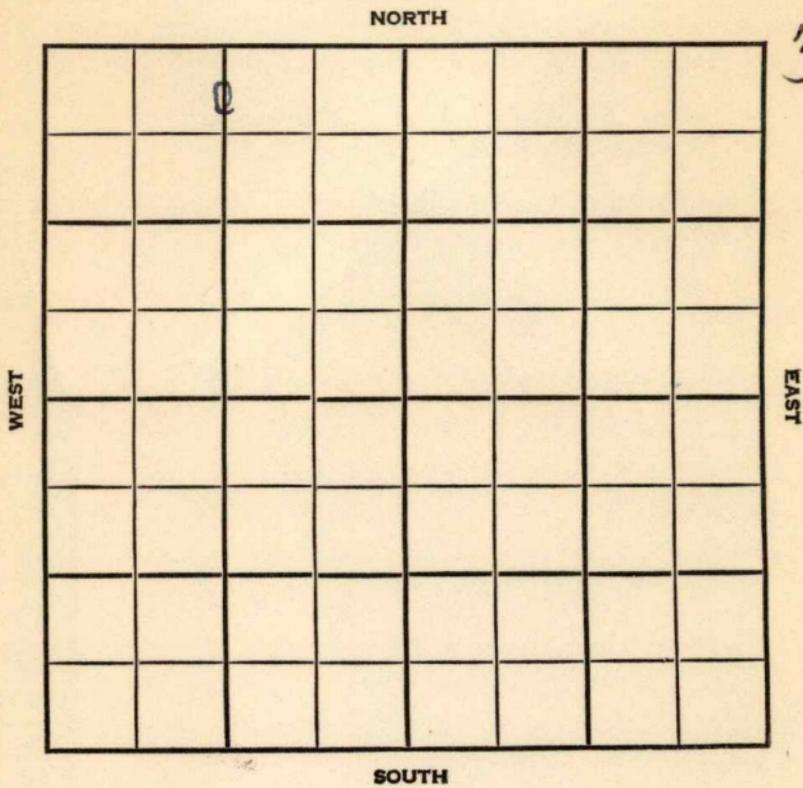

Saline

KANSAS

| | | |
|------|------|----|
| SEC. | TWP. | R. |
| 11 | 16 | 4W |

WELL NO. #2 Lagerstrom FARM

COMPANY Jones, Shelburne & Farmer

CONTRACTOR Shields

Smolan Pool


330 Ft. from N. Line

Ft. from S. Line

Ft. from E. Line

1320 Ft. from W. Line

C N $\frac{1}{2}$ N $\frac{1}{2}$ NW

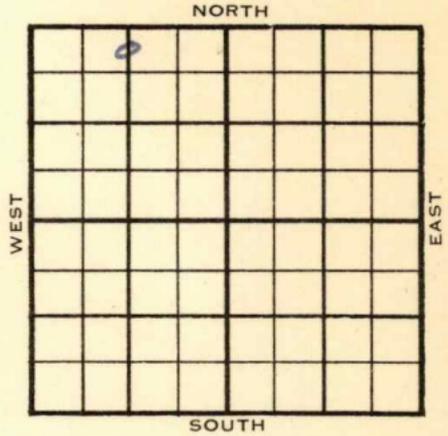

| | | |
|------|-----------|--------|
| 1954 | ELEVATION | REPORT |
| | 1355' | |

11/3 Spud 11-1-54
8" @ 365'
WOC.

12/15 Spud 11-1-54
Oil Well.
TD 3469'
8" @ 365'
Maw. 3467'
TD 3468'
5" @ 3466'
DD 3469' S/ 1 $\frac{1}{4}$ boph 500 A S/ 1 $\frac{1}{2}$
bo 1 $\frac{1}{2}$ bw.
Comp 22 bopd. 22 bw.

COMPLETED

County **Saline** State **Kansas**

Sec. **11** (Blk.) **16** (Sur.) **4W** Map No.
(Twp.)

Operator **Jones, Shelburne & Farmer**

Well No. **2** Farm **Lagerstrom**

Elev. Location **C N $\frac{1}{2}$ N $\frac{1}{2}$ NW**

| | | | | | |
|--|--|--|--|--|--|
| | | | | | |
| | | | | | |
330 Ft. From **N** Line **NW**

1320 Ft. From **W** Line **Quarter**

lst. Report **NOV 3 1954**

Completion

Remarks

Shields - Contr.

Spudding Date **11-1-54**

Smolan Pool

Drlg. Data **8" @ 365 WOC**

FABEN GILSTRAP

County Saline State Kansas

Sec. 11 (^{Blk.}_{Twp.}) 16 (^{Sur.}_{Rge.}) 4W Map No.

Operator Jones, Shelburne & Farmer

Well No. 2 Farm Lagerstrom

Elev. 1355 Location C N $\frac{1}{2}$ N $\frac{1}{2}$ NW

| | | | | | |
|--|--|--|--|--|--|
| | | | | | |
| | | | | | |
330 Ft. From N Line NW
1320 Ft. From W Line Quarter

Ist. Report _____

Completion DEC 15 1954

Remarks Smolan Pool

Shields - Contr.

Spudding Date 11-1-54

Drig. Data Oil well TD 3469

8" @ 365 Maw. 3467 TD 3468 5" @ 3466

DD 3469 S/ 1 $\frac{1}{4}$ boph 500 A S/ 1 $\frac{1}{2}$ bo

1 $\frac{1}{2}$ bw Comp. 22 bopd 22 bw

FABEN GILSTRAP