

Cowley

KANSAS 3E

Section 33 Township 33 Range 3E

Well No. 2 Aumann

Company Drillers Production

NORTH

						0	

SOUTH

WEST

EAST

KANSAS

Cowley

33

33

3E

Sec. _____ Twp. _____ R. _____

#2 Aumann

Well No. _____ Farm _____

Drillers Production

Company _____

Springer & Harper

NE Enterprize Pool

Contractor _____

330

Ft. from N. Line


Ft. from S. Line

990

Ft. from E. Line

Ft. from W. Line

NW NE NE

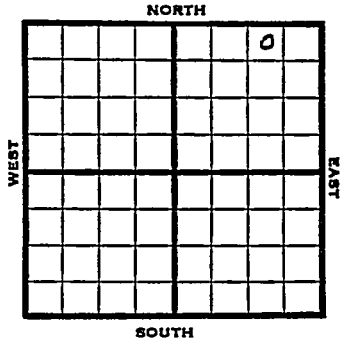

REPORT

1952

Elev. 1136'

12/17 8" @ 92

12/30

Spud 12-14-52

D & A TD 3363' 8" @ 92

Lans. 2202' Layton 2642' KC 2826'

B' KC 2945' Marm. 3024' Cherokee 3147'

Bart. 3343' Miss 3348'

TD 3363' D & A

ABANDONED

