

Section 33 Township 33 Range 3EWell No. #3 AumannCompany Drillers Prod.

				0			

NORTH

WEST

EAST

SOUTH

Cowley KANSAS

Sec. 33 Twp. 33 R. 3E

Well No. #3 Aumann Farm

Drillers Prod. Company

Springer & Harper Contractor
Gueda Springs Pool


330 Ft. from N. Line

 Ft. from S. Line

 Ft. from E. Line

330 Ft. from W. Line

NW NW NE

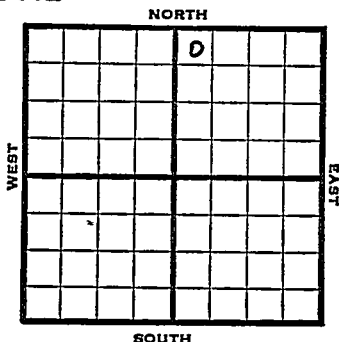

1953

Elev. 1111'

REPORT

5/6

Spud 5-4-53

6/24

Spud 5-4-53

Oil Well

TD 3319

8" @ 102

Lans 2169, Layton 2609, KC 2798,

B KC 2909, Marm. 2991, Cherokee 3105,

Bart 3262, Miss 3318

TD 3319

5" @ 3319

CO to 3315

68/3282-94, F/15 boph

Comp. 35 bopd

COMPLETED

County Cowley State KansasSec. 33 (Blk. Twp.) 33 (Sur. Rge.) 3E Map No.Operator Drillers Prod.Well No. 3 Farm AumannElev. Location NW NW NE

330 Ft. From N Line NE330 Ft. From W Line Quarter1st. Report MAY 6 1953

Completion

Remarks

Springer & Harper - ContrSpudding Date 5-4-53Drlg. Data Gueda Springs Pool

J. G. McGEHEE

Sec. 33 (Blk. Twp.) 33 (Sur. Rge.) 3E Map No.

Well No. 3 Farm Aumann

Elev.	1111	Location	NW NW NE
-------	------	----------	----------

0

COMPLETE

330 Ft. From N Line NE

330 Ft. From W Line Quarter

1st. Report

Completion JUN 24 1953

Remarks Gueda Springs Pool
Springer & Harper - Contr.

Spudding Date 5-4-53

Drlog. Data Oil well TD 3319

8" @ 102 Lens. 2169 Layton 2609

KC 2798 B KC 2909 Marm. 2991

Cherokee 3105 Bart. 3262 Miss. 3318

TD 3319 5" @ 3319 CO to 3315

68/ 3282-94 F/ 15 boph

Comp. 35 bopd

J. G. McGEHEE