
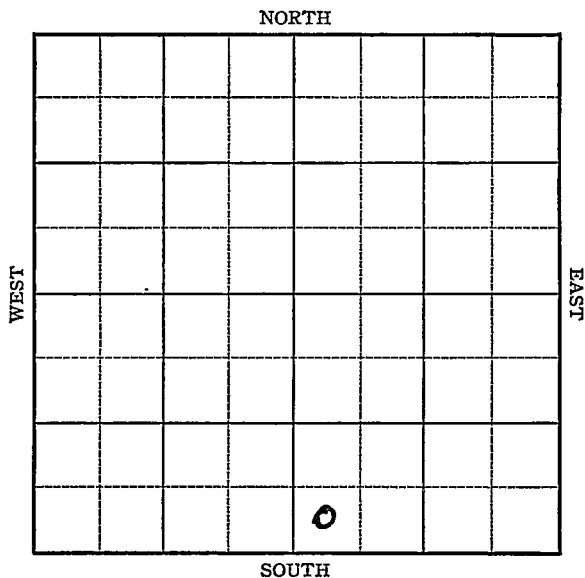


Section 7 Township 16 Range 13-WWell No. 2 McClanahanCompany Phillips

Sec. 7 Twp. 16 R. 13-W
Well No. #2 McClanahan Farm
Phillips Company

330 Ft. from W. Line

Elev. 1932

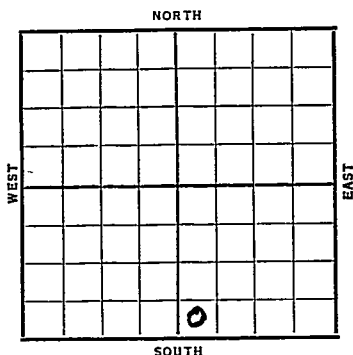

Date	REPORT
1937	
11/10	Location
11/19	T.D. 640' Reaming.
11/26	10 $\frac{1}{8}$ " @ 640'. T.D. 910' SD.
12/3	Anhy 885'. Drl g. 2215'. .
12/10	Topeka 2810'. K.C. 3120'.
	Sat. 3129-33'. T.D. 3135'.
	Shut down.
12//17	Sil. & 7" @ 3349'I T.D. 3350'.
	No shows rept. RUST.
12/24	T.D. 3364'. Swab 374 bbls. oil 8 hrs.
12/31	T.D. 3364'. 4000 acid.
	OVER

1938

1/5

7" @ 3349'.

Arb. 3349'.

T.D. 3364'.

4000 acid.

Potential 2312 bbls.

COMPLETED

Barton

KANSAS

Map No. _____ Sec. 7 Twp. 16 R. 13WWell No. 2 McClanahanPhillips

Company _____

Contractor _____

FIRST REPORT

SW SE

_____ Ft. from N. Line

330 Ft. from S. Line

_____ Ft. from E. Line

330 Ft. from W. Line

SECTION PLAT

		0	

Location X

Rig up _____

Drilling and Remarks: _____

RECORD

Cased _____ in., _____ ft.

Sand _____

Gas _____

Oil _____

Total Depth _____

PRODUCTION

1st 24 hrs. Nat. _____

1st 24 hrs. after shot _____

Gas _____ Cu. Ft.

Dry Hole _____

Abandoned _____

Date

NOV 10 1937 19

H. D. Hatfield

Scout

Barton

Map No. 73 Sec. 7 Twp. 16 R. 13WWell No. 2 McClanahanPhillips Company

Contractor

COMPLETED

SW SE

SECTION PLAT

		0	

 Ft. from N. Line330 Ft. from S. Line Ft. from E. Line330 Ft. from W. LineLocation Rig up

Drilling and Remarks:

400 acidPOT - 2312

RECORD

Cased 7 in., 3349 ft.Sand Arb 3349Gas Oil Total Depth 3364

PRODUCTION

1st 24 hrs. Nat. 1st 24 hrs. after shot Gas Cu. Ft.Dry Hole Abandoned

Date

JAN 5 - 1938 19E. D. Hatfield Scout