


Section 15 Township 16 Range 8-W

Well Number 1 Larkin

Company Orvall Lee et al

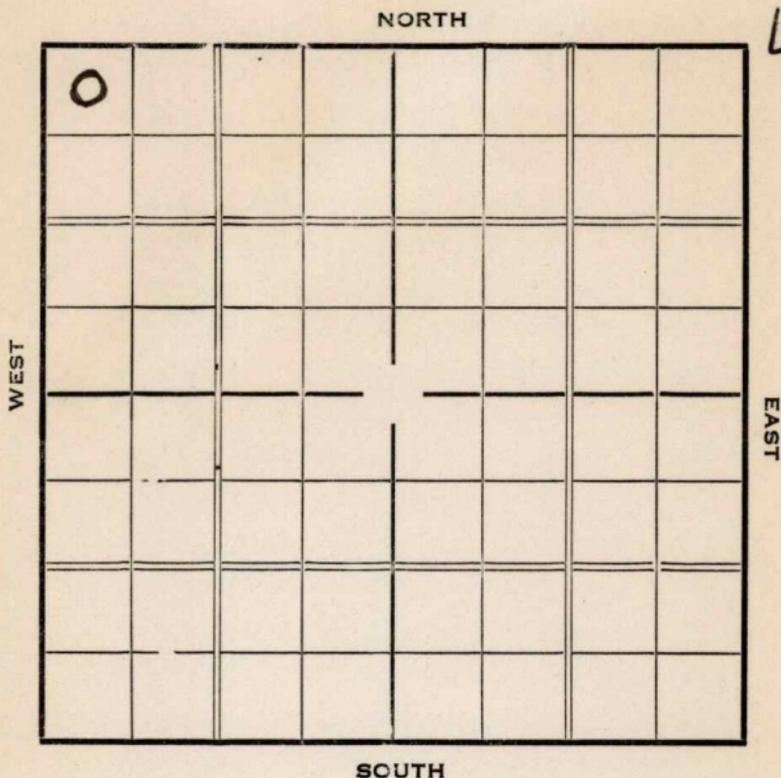

Sec. 15 Twp. 16 R. 8-W

Well No. #1 Larkin Farm


Orvall Lee et al Company

330 Ft. from N. Line

_____ Ft. from S. Line

_____ Ft. from E. Line

330 Ft. from W. Line

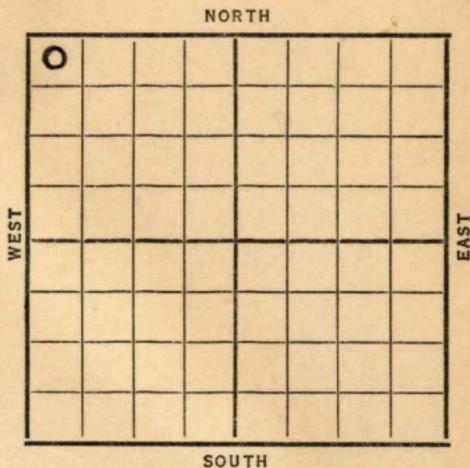

Special

Date **Elev. 1623** REPORT

1937

3/24 Rig

4/2 Rigging up.

4/8 Spud

4/16 Spud & SD

4/23 " "

4/30 Drlg. 390'.

5/7 Fsg. 395'.

5/14 **Anhy 455'**. 12" @ 460'.

Show gas 1100'. Drlg. 1395'

5/21 **Topeka 2275'**. Drlg. 2274'.

5/28 S.G. 2320'. 8" @ 2365'.

Est. 1/2 M gas 2512-20' H.F.W

at 2530-50'. T.D. 2595'.

U.R. 8".

6/4 **K.C. 2620'** **S.O. 2688-94'**.

S.W. ~~2690-2725'~~ 8" @ 2735'.

2690-2725'

Drlg. 2830'.

OVER

1937

6/11 Base K.C. 2930'.

H.F.W. 3058'.

S.G. 3061'. T.D. 3073'.

U.R. 8".

6/16 Sil. 3047'.

T.D. 3080'. H.F.W.

ABANDONED

Map No. 45 Sec. 15 Twp. 16 R. 8W.

Well No. 1 Larkin

Oswall Lee et al Company

Contractor

Special

SECTION PLAT

| | | | |
|---|--|--|--|
| 0 | | | |
| | | | |
| | | | |
| | | | |

230 Ft. from N. Line

_____ Ft. from S. Line

_____ Ft. from E. Line

230 Ft. from W. Line

FIRST REPORT

Location _____

Rig up _____

Drilling and Remarks:

Rig

RECORD

Cased _____ in., _____ ft.

Sand _____

Gas _____

Oil _____

Total Depth _____

PRODUCTION

1st 24 hrs. Nat. _____

1st 24 hrs. after shot _____

Gas _____ Cu. Ft.

Dry Hole _____

Abandoned _____

Date

MAR 24 1937

19

S. J. LEWIS

Scout

KANSAS

Ellsworth

Map No. 45 Sec. 15 Twp. 16 R. 8^w

Well No. 1-Larkin

Orville Lee et al Company

Contractor

SECTION PLAT

ABANDONED

330 Ft. from N. Line

560 Ft. from S. Line

 Ft. from E. Line

330 Ft. from W. Line

| | | | |
|---|--|--|--|
| 0 | | | |
| | | | |
| | | | |
| | | | |

Location _____

Rig up _____

Drilling and Remarks:

HFW

DNA

RECORD

Cased _____ in., _____ ft.

Sand 511 3047

Gas _____

Oil _____

Total Depth 3080

PRODUCTION

1st 24 hrs. Nat. _____

1st 24 hrs. after shot _____

Gas _____ Cu. Ft.

Dry Hole _____

Abandoned _____

Date

JUN 16 1937 19

H. D. Hatfield Scout