


Section 11 Township 16 Range 4 W

Well No. # 1 Bloomquist

Company Franco Central & Penguin Drlg.

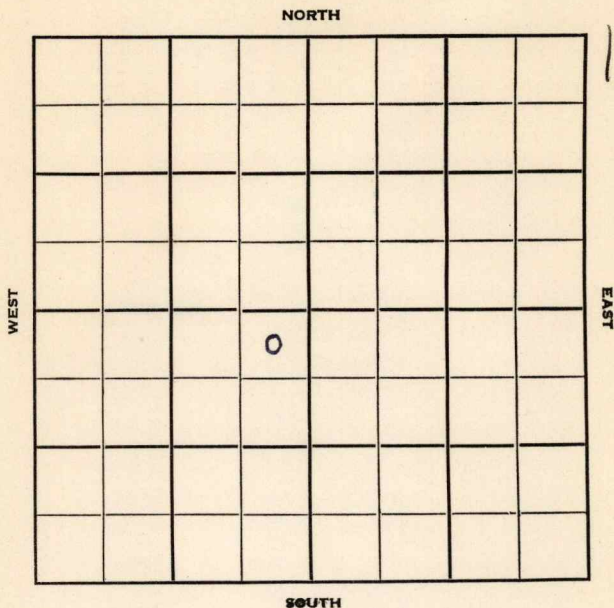

Saline

KANSAS

Sec. 11 Twp. 16 R. 4 W

Well No. # 1 Bloomquist Farm

Franco Central & Penquin Drlg. Company

Mallard Drlg. Contractor


330 **Wildcat**
Ft. from N. Line

_____ Ft. from S. Line

330 Ft. from E. Line

_____ Ft. from W. Line

NE NE SW

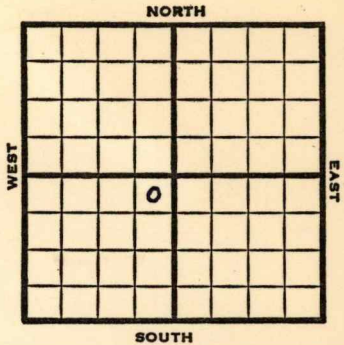

1951

Elev. 1332' REPORT

2/14

Location

3/21

Spud 2-23-51
Oil W 11 TD 3640
8" @ 225'

Lans. 2991' Miss 2942

Kinderhook 3235' Maq. 3461

DST 3459-65 opn 45 min. Rec. 20' mud
& SSO

Viola 3515 Simp 3595 SO 3605-15

TD 3640 FU 1000' water 1 hr

SP 3550 25/3494-98 SSO

1000 A S/1 bwph SP 3480 40/3460-70

SSO 1000 A FU 1400' water

S/24 bwph D&A

ABANDONED

County Saline State Kansas

Sec. 11 (Blk. 16 (Sur. 4W (Twp.) Rge.) Map No.

Operator Franco Central & Penguin Drlg.

Well No. 1 Farm Bloomquist

Elev. _____ Location NE NE SW

FIRST REPORT									

330 Ft. From N Line SW

330 Ft. From E Line Quarter

1st. Report FEB 14 1951

Completion _____

Remarks _____

Penguin Drlg. - Contr.

Spudding Date _____

Drlg. Data Wildcat

Location _____

J. E. TYRA

County Saline State Kansas

Sec. 11 (^{Blk.} ^{Twp.}) 16 (^{Sur.} ^{Rge.}) 4W Map No.

Operator Franco Central & Penguin Drlg.

Well No. 1 Farm Bloomquist

Elev. 1332 Location NE NE SW

BANDONED

330 Ft. From N Line SW

330 Ft. From E Line Quarter

1st. Report

Completion MAR 21 1951

Remarks Wildcat

Mallard Drlg. - Contr.

Spudding Date 2-23-51

Drlg. Data Oil well TD 3640

8" @ 225 Lans. 2291 Miss. 2942

Kinderhook 3235 Maq. 3461 DST 3459-65

open 45 min. Rec. 20' mud & SSO

Viola 3515 Simp. 3595 SO 3605-15

TD 3640 FU 1000' water 1 hr. SP 3550

25/ 3494-98 SSO 1000 A S/ 1 bwph

SP 3480 40/ 3460-70 SSO 1000 A

FU 1400' water S/ 24 bwph

D & A