

KANSAS


Saline

FORM 51 5M 10-41 PETROL

Section 34 Township 16 Range 4-W

Well No. #1 Lindshield

Company Brain & Goering

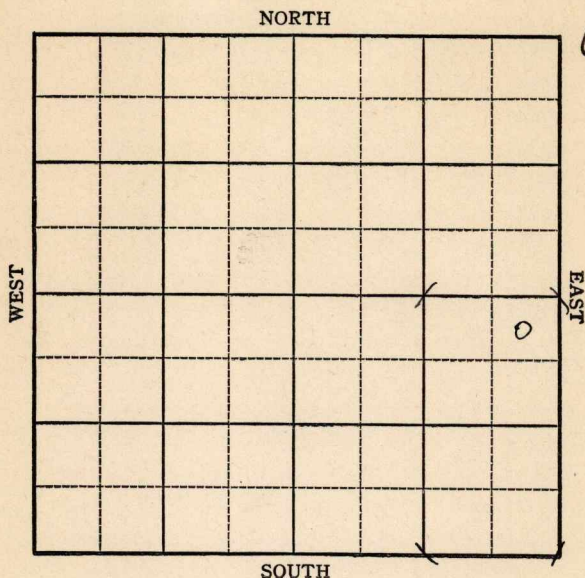

KANSAS

Saline

Sec. 34 Twp. 16 R. 4-W

Well No. #1 Lindshield Farm

Brian & Goering Company

Wildcat

330 Ft. from N. Line


Ft. from S. Line

330 Ft. from E. Line

Ft. from W. Line

NE SE

Elev. 1476

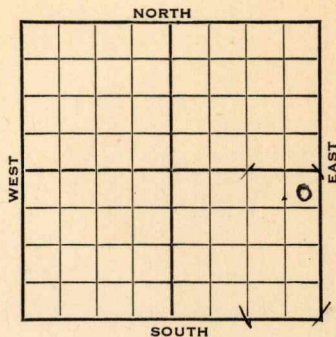

1943

REPORT

1/20 Rotary

1/27 12" Casing set 153'
Drlg. 2180'

2/3 Miss. 3175'
Drlg. 3474'

2/10 Misener 3638
Viola 3694
Simpson 3794
Arb 3869
T.D. 3904'
No shows

ABANDONED

Saline

KANSAS
 Map No. 44 Sec. 34 Twp. 16 R. 4W


Well No. 1 LindshieldBrian & Goering

Company

Contractor

NE SE

SECTION PLAT

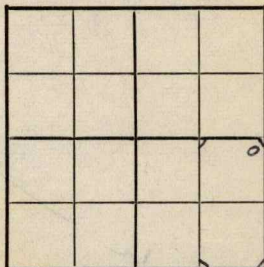330 Ft. from N. Line Ft. from S. Line330 Ft. from E. Line Ft. from W. Line

WILDCAT

RECORD

Location Rig up

Drilling and Remarks:

Rotary

Cased in., ft.Sand Gas Oil Total Depth

PRODUCTION

1st 24 hrs. Nat. 1st 24 hrs. after shot Gas Cu. Ft.Dry Hole Abandoned

Date

JAN 20 1943

19

S. J. LEWIS

Scout

Saline

KANSAS

Map No. 44 Sec. 34 Twp. 16 R. 4WWell No. 1 LindshieldBrian & Goering Company

ABANDONED

Contractor

NE SE

SECTION PLAT

330 Ft. from N. Line Ft. from S. Line330 Ft. from E. Line Ft. from W. Line

			0

WILDCAT

Location Rig up

Drilling and Remarks:


RECORD

Cased in., ft.Sand Gas Oil Total Depth 8904

PRODUCTION

1st 24 hrs. Nat. 1st 24 hrs. after shot Gas Cu. Ft.Dry Hole Abandoned

Date

FEB 10 1943

19

S. J. LEWIS

Scout