


KANSAS

Map No. _____ Sec. 7 Twp. 16 R. 5w
Well No. 1-Peterson Farm
N.M. Esty et al Company

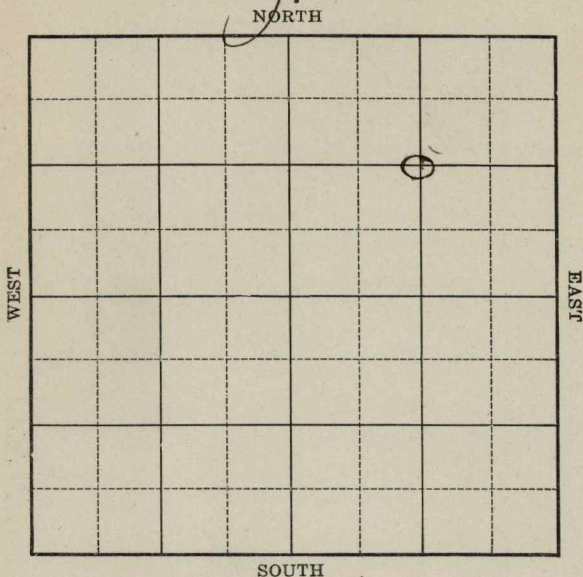

Location _____

Drilling Remarks _____

Rig Up _____

Drilling Remarks _____

RECORD

Cased _____ in. _____ ft.

Sand _____

Gas _____

Oil _____

Total Depth _____

PRODUCTION

1st 24 hrs. Nat. _____

1st 24 hrs. after shot _____

Gas _____ cu. ft.


Dry Hole _____

Abandoned _____

Map No. **KANSAS** Sec. **46** Twp. **16** R. **5w**

 Well No. **1- Peterson** Farm
N. M. Esty et al Company

NORTH

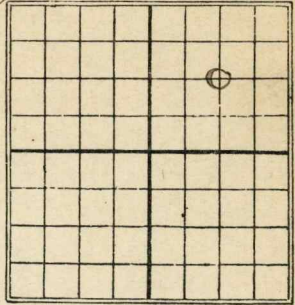
1320 Ft. from N. Line

_____ Ft. from S. Line

1320 Ft. from E. Line

_____ Ft. from W. Line

SOUTH

1928

Date

REPORT

4/11	R.O.G.
4/18	—
4/25	Rig
5/2	—
5/9	Rigging up-
5/16	Spud
5/23	No report
5/31	- Spud - S.D.
6/6	— 9/19 —
6/13	— 9/26 —
6/20	— 10/3 —
6/27	— 10/10 —
7/3	—
7/11	—
7/18	—
7/25	—
8/1	—
8/7	—
8/15	—
8/22	—
9/5	—
9/12	—

(over)

10/17 - Moving in tools

10/24 _____

10/31 - S.D.

11/7 - Rigging up

11/14 _____

11/21 _____

11/28 _____

12/5 _____

12/12 _____

12/19 _____

12/26 _____

12/29 _____

1/2 _____

1/9 - S.D.

1/16 _____

1/23 _____

1/30 _____

2/6 _____

2/13 _____

2/20 _____

2/27 _____

3/6 _____

3/13 _____

3/20 _____

3/27 _____

4/3 _____

4/10 _____

4/17 _____

4/24 _____

5/1 -

Spudded

Dry & Abandoned

no well
Form 26 1M Bks. 3-23-11959.

Map No. **KANSAS** Sec. 16 Twp. 16 R. 5W

Well No. 1 Peterson

N. M. Estey & Co. Company

Contractor

SECTION PLAT

1320 Ft. from N. Line

----- Ft. from S. Line

1320 Ft. from E. Line

----- Ft. from W. Line

FIRST REPORTS

Location -----

Rig up -----

Drilling and Remarks:

RCG

RECORD

Cased ----- in., ----- ft.

Sand -----

Gas -----

Oil -----

Total Depth -----

PRODUCTION

1st 24 hrs. Nat. -----

1st 24 hrs. after shot -----

Gas ----- Cu. Ft.

Dry Hole -----

Abandoned -----

Date

APR 11 1928

S. J. LEWIS

Scout

Map No. 1820 Sec. 6 Twp. 16 R. 5W

Well No. 1 Peterson

N.M. Esty & Co. Company

Contractor

SECTION PLAT

1820 Ft. from N. Line

_____ Ft. from S. Line

1820 Ft. from E. Line

_____ Ft. from W. Line

Correction

Location _____

Rig up _____

Drilling and Remarks:

Reported this in
5-16-5W. should
be 6-16-5W

RECORD

Cased _____ in., _____ ft.

Sand _____

Gas _____

Oil _____

Total Depth _____

PRODUCTION

1st 24 hrs. Nat. _____

1st 24 hrs. after shot _____

Gas _____ Cu. Ft.

Dry Hole _____

Abandoned _____

Date

APR 25 1928

192

S. J. LEWIS

Scout

Caline
 Map No. **KANSAS** Sec. 6 Twp. 16 R. 5W
 nonap

Well No. Peterson

N. M. Esty & Co. Company

Contractor


SECTION PLAT

1320 Ft. from N. Line

..... Ft. from S. Line

1320 Ft. from E. Line

..... Ft. from W. Line

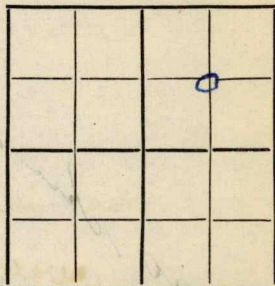

Location.....

Rig up.....

Drilling and Remarks:

Spud

D & A

RECORD

Cased..... in., ft.

Sand.....

Gas.....

Oil.....

Total Depth.....

PRODUCTION

1st 24 hrs. Nat.....

1st 24 hrs. after shot.....

Gas..... Cu. Ft.

Dry Hole.....

Abandoned Loc

Date

MAY 1 1929

S. J. LEWIS

..... 192..... Scout