


Section 25 Township 16 Range 5W

Well No. #1 Hawkinson

Company Republic Natural Gas

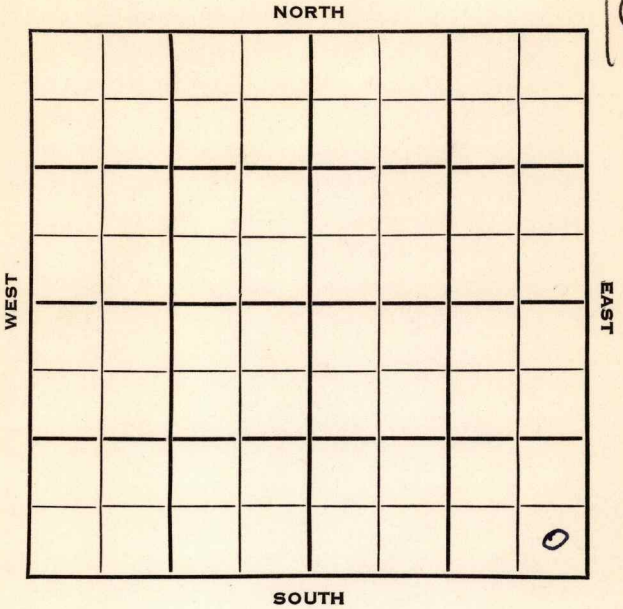

Saline

KANSAS



Sec. 25 Twp. 16 R. 5W

Well No. #1 Hawkinson Farm

Republic Natural Gas Company

Melland Drlg. Contractor

Wildcat


Ft. from N. Line

330 Ft. from S. Line

330 Ft. from E. Line

Ft. from W. Line

SE SE SE

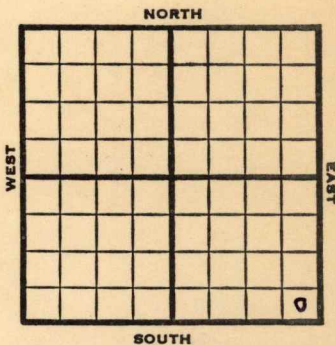

1953 Elev. 1544' RB REPORT

1496 LS

- 7/29 Spud 7-21-53
8" @ 340
Heeb 2379, Doug 2411, Lans 2583
Drlg. 2800'
- 8/5 Miss 3234' KH 3502' V 3742'
Drlg. 3780'
- 8/12 Spud 7-21-53 D & A TD 3966
8" @ 340 Heeb 2379 Doug. 2411
Lans 2583 Miss 3234 Kh. 3502
Viola 3742 Simp. 3793
TD 3966 Arb. 3909 D & A

ABANDONED

County Saline State Kansas

Sec. 25 (Blk. Twp.) 16 (Sur. Rge.) 5W Map No.

Operator Republic Natural Gas

Well No. 1 Farm Hawkinson

Elev. 1544 RB Location SE SE SE

330 Ft. From S Line SE

330 Ft. From E Line Quarter

1st. Report JUL 29 1953

Completion

Remarks

Melland Drlg. - Contr.

Spudding Date 7-21-53

Drlg. Data Wildcat

8" @ 340 Heeb. 2379 Doug. 2411

Lens. 2583 drlg. 2800

County Saline State Kansas

Sec. 25 (Blk. 16) (Sur. 5W) (Twp.) 16 Map No.

Operator Republic Natural Gas

Well No. 1 Farm Hawkinson

Elev. 1496 LS Location SE SE SE
1544 RB

330 Ft. From S Line SE

330 Ft. From E Line Quarter

1st. Report

Completion AUG 12 1953

Remarks Wildcat

Melland Drlg. - Contr.

Spudding Date 7-21-53

Drlg. Data D & A TD 3966

8" @ 340 Heeb. 2379 Doug. 2411

Lans. 2583 Miss. 3234 Kh. 3502

Viola 3742 Simp. 3793 TD 3966

Arb. 3909

D & A

J. G. McGEHEE