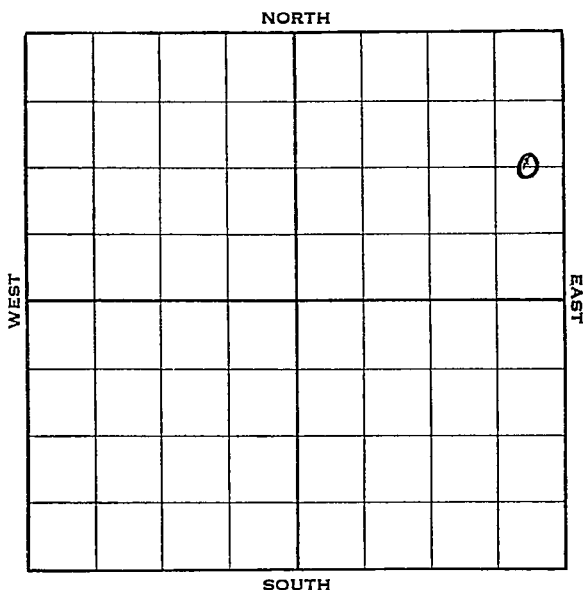



Section 7 Township 16 Range 13-WWell No. 2 HoffmanCompany Sinclair-Prairie

KANSAS

Barton

Sec. 7 Twp. 16 R. 13-77Well No. #2 Hoffman FarmSinclair-Prairie Company1320 Ft. from N. Line Ft. from S. Line330 Ft. from E. Line Ft. from W. Line

Elev. 1924

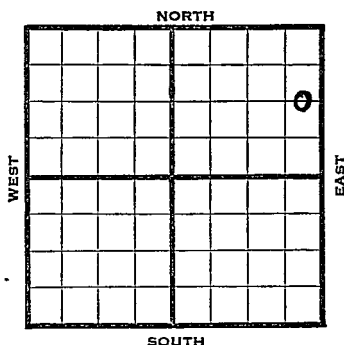

1938	REPORT
4/6	B.R.R.
4/15	R U R
4/22	13" @ 163'. Drlg. 1770'.
4/29	Drlg. 2960'.
5/6	Arb. 3368-72' T.D. Good Sat. 7" @ 3370'. RUST.
5/12	Arb. & 7" @ 3365'. (Corrected) T.D. 3371'. Swab 281 oil in 8 hours.
5/18	7" @ 3365'. Arb. 3365'. T.D. 3371'. 2000 acid. Potential 1274 bbls.
	COMPLETED

Barton KANSAS

Map No. 73 Sec. 7 Twp. 16 R. 13WWell No. 2 HoffmanSinclair Prairie

Company

Contractor

FIRST REPORT

SECTION PLAT

C E L N E

1320 Ft. from N. Line Ft. from S. Line330 Ft. from E. Line Ft. from W. Line

			0

Location Rig up Drilling and Remarks:
BRR

RECORD

Cased in., ft.Sand Gas Oil Total Depth

PRODUCTION

1st 24 hrs. Nat. 1st 24 hrs. after shot Gas Cu. Ft.Dry Hole Abandoned

Date

APR 6 - 1938 19 H. D. Hatfield Scout

Barton KANSAS

Map No. 73 Sec. 7 Twp. 16 R. 13WWell No. 2 HoffmanSinclair Prairie

Company

Contractor

COMPLETED

C E L N E

1320

Ft. from N. Line

Ft. from S. Line

330

Ft. from E. Line

Ft. from W. Line

SECTION PLAT

Location

Rig up

Drilling and Remarks:

*2000 acid**LOT 1274*

RECORD

Cased 7 in., 3365 ft.Sand 416 3365

Gas

Oil

Total Depth 3371

PRODUCTION

1st 24 hrs. Nat.

1st 24 hrs. after shot

Gas Cu. Ft.

Dry Hole

Abandoned

Date

MAY 18 1938

19

H. D. Hatfield

Scout