


Map No. **KANSAS** Sec. 17 Twp. 16 R. 7W
 Well No. 1- Hochman Farm
Phillips Pet Company

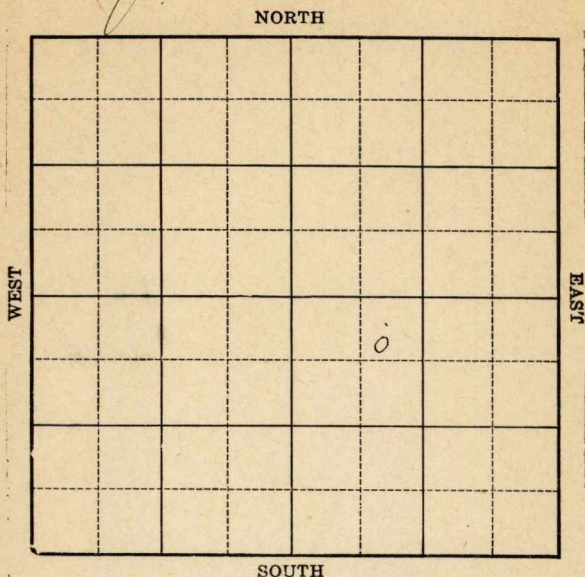

Location _____
 Drilling Remarks _____

Rig Up _____
 Drilling Remarks _____

RECORD

Cased _____ in. _____ ft.
 Sand _____
 Gas _____
 Oil _____
 Total Depth _____

PRODUCTION

1st 24 hrs. Nat. _____
 1st 24 hrs. after shot _____
 Gas _____ cu. ft.
 Dry Hole _____
 Abandoned _____

Map No. **KANSAS** Sec. 17 Twp. 16 R. 7^w


Well No. 1- Hochman Farm
Phillips Pet Company

3084 1/2 Ft. from N. Line *of sec*

 Ft. from S. Line

1771 1/2 Ft. from E. Line

 Ft. from W. Line

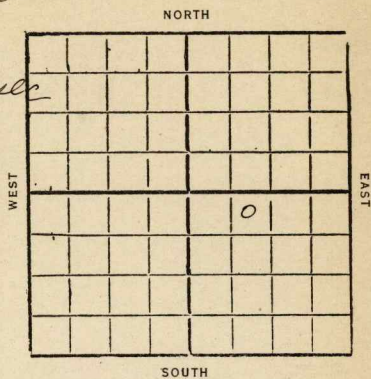

1932

Date

REPORT

8/3	Loc
8/10	Bldg rig
8/17	Rig up
8/24	dreg water well
8/31	Rig up 4517 for water
9/7	dreg 160'
9/14	20"-58
	15"-368
	12"-884
	dreg 925
9/21	" 1758'
9/30	show gas 1050
	" " 1855-60
	10"-1937
	6 bailer water 2380-90
	dreg 2437
10/5	8"-2553
	dreg 2765'
10/12	TL 2932' U/R 8"
	(Over)

10/18- Top Conglomerate 2980
Green shale 3005-10
HFW 3026-32
Unable to get on bottom
Hole caving badly
(Think maybe top of Siliceous)
Kill 5/R and lower pipe

10/19- TD 3032' HFW
6"-2977'

10/26- Top Simpson 3045
" Siliceous 3059
SD 3065' HFW

11/2- Top Cong 2980
" Simpson 3045
" Siliceous 3059
TD 3065' HFW
Abandoned

Ellsworth

W

45 KANSAS

Map No. _____ Sec. 17 Twp. 16 R. 7

Well No. 1 Hochman

Phillips Pet Co Company

Contractor

FIRST REPORTS


SECTION PLAT

3084 1/2 Ft. from N. Line of Sec.

_____ Ft. from S. Line

1771 1/2 Ft. from E. Line

_____ Ft. from W. Line

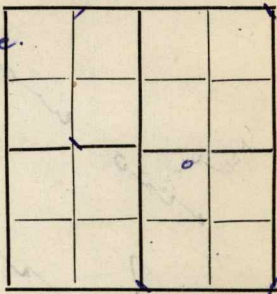

Location ✓

Rig up

Drilling and Remarks:

RECORD

Cased _____ in., _____ ft.

Sand _____

Gas _____

Oil _____

Total Depth _____

PRODUCTION

1st 24 hrs. Nat. _____

1st 24 hrs. after shot _____

Gas _____ Cu. Ft.

Dry Hole _____

Abandoned _____

Date

AUG 3 1932

192

CHAS. L. SHERWOOD

Scout

Ellsworth

45 **KANSAS** Map No. Sec. 17 Twp. 14 R. 7 W

Well No. 1 Hochman

Phillips pet Co Company

Contractor

COMPLETED**SECTION PLAT**3084 $\frac{1}{2}$ Ft. from N. Line of Sec

Ft. from S. Line

Ft. from E. Line

1771 $\frac{1}{2}$ Ft. from W. Line**ABANDONED**

		0	

Location

Rig up

Drilling and Remarks:

Top Layer 2980
 " Simpson 3045
 " Siliceous 3059
 HFW 3065

RECORD

Cased in., ft.

Sand

Gas

Oil

Total Depth 3065

PRODUCTION

1st 24 hrs. Nat.

1st 24 hrs. after shot

Gas Cu. Ft.

Dry Hole ✓

Abandoned ✓

Date

NOV 2 1932 CHAS. L. SHERWOOD

192 Scout