


Barton KANSAS

O. W. P. B

Section 7 Township 16 Range 13-W

Well No. 2 Hoffman "B"

Company ~~I. T. I. O.~~ C. S. O.

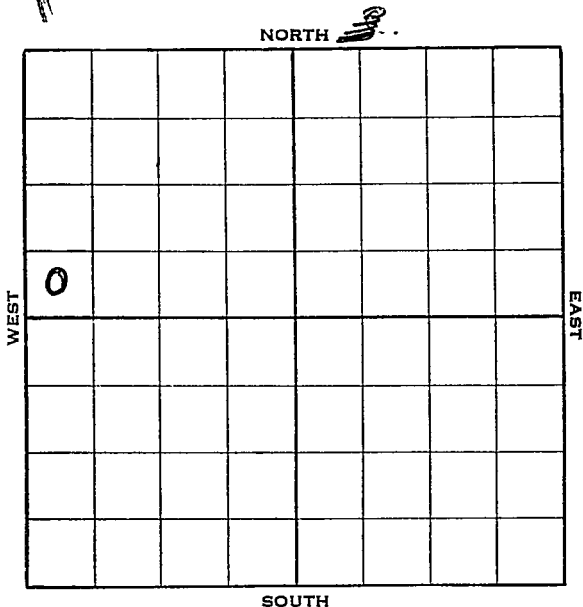

KANSAS

Barton

Sec. 7 Twp. 16 R. 13-W

Well No. #2 Hoffman "B" Farm

ITIO

Company

_Ft. from N. Line

330


Ft. from S. Line

Ft. from E. Line

330²

_Ft. from W. Line

Elev. 1918

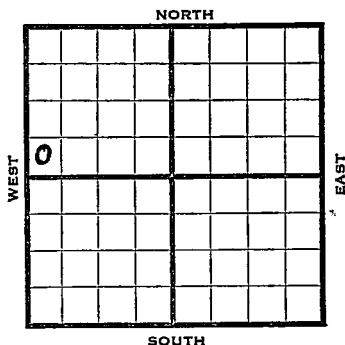[illegible]

Barton

KANSAS

Map No. 73 Sec. 7 Twp. 16 R. 13WWell No. 2 Hoffman "B"I T I O

Company

Contractor

FIRST REPORT
SW NW**SECTION PLAT**

0			

 Ft. from N. Line330 Ft. from S. Line Ft. from E. Line330 Ft. from W. LineLocation Rig up

Drilling and Remarks:

RR**RECORD**Cased in., ft.Sand Gas Oil Total Depth **PRODUCTION**1st 24 hrs. Nat. 1st 24 hrs. after shot Gas Cu. Ft.Dry Hole Abandoned

Date

AUG 31 193819H. D. Hatfield Scout

Barton KANSAS

Map No. _____ Sec. 7 Twp. 16 R. 13WWell No. 2 Hoffman "B"

I T I O

Company _____

Contractor _____

COMPLETED

SW NW

_____ Ft. from N. Line

330 Ft. from S. Line

_____ Ft. from E. Line

330 Ft. from W. Line

SECTION PLAT

0			.

Location _____

Rig up _____

Drilling and Remarks:

*2000 acid**POT 14.96*

RECORD

Cased 7 in., 3338 ft.~~Sand~~ *Arb* 5339

Gas _____

Oil _____

Total Depth 3361

PRODUCTION

1st 24 hrs. Nat. _____

1st 24 hrs. after shot _____

Gas _____ Cu. Ft.

Dry Hole _____

Abandoned _____

Date

OCT 12 1938 19 H. D. Hatfield Scout

ELEV1918DF

SEC. 7

TWPR

RGE.

13W

COMPANY C. S. O.

No. 2

FIRST REPORT

FARM Hoffman "B"

LOC. SW SW NE

(O.W.P.E.)

Lans. 3100

Arb 3339

GEOL.

CONTR

POOL

SPUD

OLF INFO: Tops. 7" @
3338, Arb well.

NEW INFO: PB 3260,
42/3197-3208, 49/3131-44,
20/3115-20, 2500A, P 7
BO + 33 BW/24,

OTD 3361

~~COMPLETE~~

80

USE

$$\frac{Z}{O}$$

5
FE

TWP

RGF