


Ellsworth

Form 51-5M-5-34-Palace

Map No. _____ Sec. 19 Twp. 16 R. 8W

Well No. #1 Gregory Farm
Pryor & Lockhart Company

NORTH

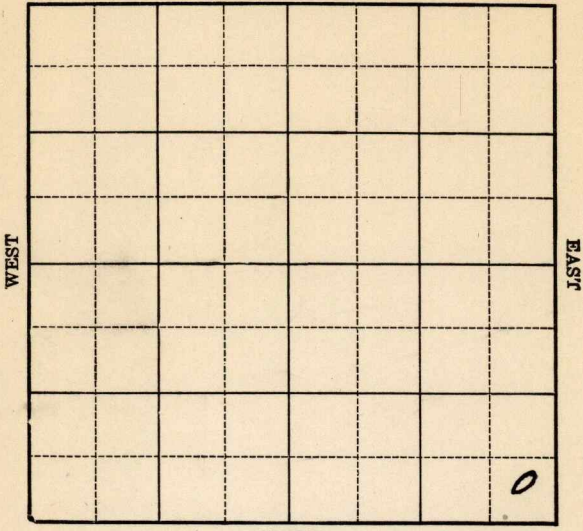

SOUTH

Location _____

Drilling Remarks _____

Rig Up _____

Drilling Remarks _____

RECORD

Cased _____ in. _____ ft.

Sand _____

Gas _____

Oil _____

Total Depth _____

PRODUCTION

1st 24 hrs. Nat. _____

1st 24 hrs. after shot _____

Gas _____ cu. ft.

Dry Hole _____


Abandoned _____

Ellsworth

Map No. **KANSAS** Sec. 19 Twp. 16 R. 8W

Well No. 1 Gregory Farm
Preyer & Lockhart Company

_____ Ft. from N. Line
330 Ft. from S. Line
330 Ft. from E. Line
_____ Ft. from W. Line

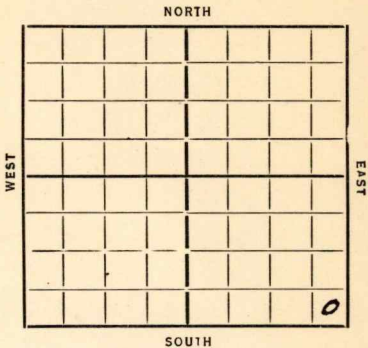

Date	REPORT
1935	
1/23	Location
1/31	Rig
2/7	_____
2/14	Rig
2/21	Spud
2/28	dlg 600
3/7	dlg 900
3/14	dlg 1545 12" 1080
3/21	" 2100 10" 2087
3/28	" 2625
4/4	MCL 2790 S.O. 2815-25
	HFW 2900 8" 2918
	HFW 2921 dlg 2935
4/11	BK C 3124 8" 2952
	dlg 3163
4/18	Viola 3274 Siliceous 3380
	T 3386
4/24	Siliceous 3380 T 3386
	17.5 ft.

ABANDONED

KANSAS

Map No. 45 Sec. 19 Twp. 16 R. 8W

Well No. 1- Gregory

Gregory & Lockhart Company

Contractor

FIRST REPORTS

SECTION PLAT

..... Ft. from N. Line

330 Ft. from S. Line

330 Ft. from E. Line

..... Ft. from W. Line

			0

Location

Rig up

Drilling and Remarks:

RECORD

Cased.....in.,ft.

Sand.....

Gas.....

Oil.....

Total Depth.....

PRODUCTION

1st 24 hrs. Nat.....

1st 24 hrs. after shot.....

Gas..... Cu. Ft.

Dry Hole.....

Abandoned.....

Date

ORVAL MANNSCHRECK

1-23-35 192.....

Scout

KANSAS

Eldsworth

Map No. 45 Sec. 19 Twp. 16 R. 8W

Well No. 1 - Gregory

Pryor & Lockhart Company
Contractor

ABANDONED

SECTION PLAT

..... Ft. from N. Line
330 Ft. from S. Line
330 Ft. from E. Line
..... Ft. from W. Line

			0

Location.....
Rig up.....
Drilling and Remarks:

NO + A

RECORD

Cased..... in., ft.
Sand silicium 3380
Gas.....
Oil.....
Total Depth 3386

PRODUCTION

1st 24 hrs. Nat.....
1st 24 hrs. after shot.....
Gas..... Cu. Ft.
Dry Hole.....
Abandoned.....

Date
4-24-35 192

ORVAL MANNSCHECK
Scout