


Section 20 Township 16 Range 8 W

Well No. # 1 Hanley

Company Elreco & Rock Island

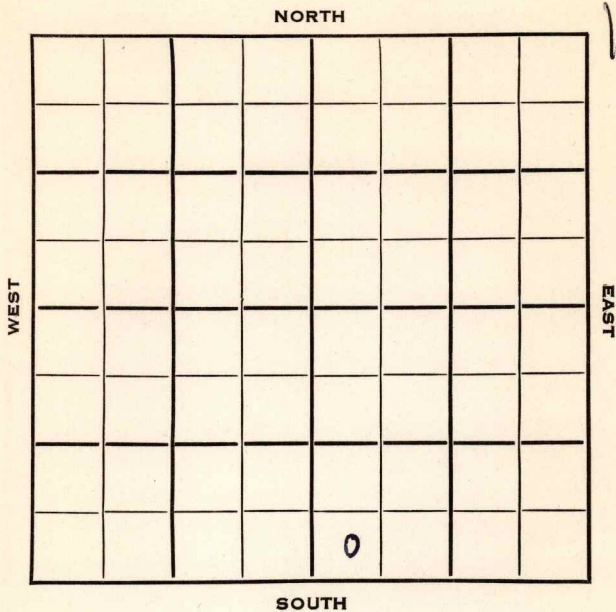

Ellsworth KANSAS ✓

Sec. 20 Twp. 16 R. 8W

Well No. #1 Hanley Farm

Elreco & Rock Island Company

Group Expl. Contractor

Wildcat


Ft. from N. Line

330 Ft. from S. Line

Ft. from E. Line

330 Ft. from W. Line

SW SW SE

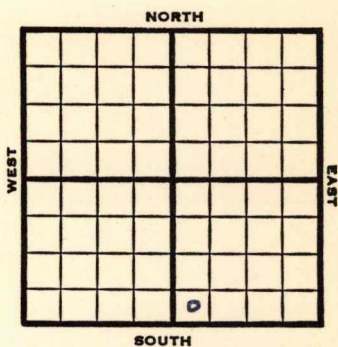

1953

Elev. 1733'

REPORT

4/15

Location

4/23

Heeb 2655 Br li 2770' Lans 2791
 B KC 3123 Cong 3179 Mq Dol 3234'
 V 3329' Drlg. 3375'

4/29

Spud 4-10-53

D&A

TD 3457

Heeb 2655, Br lime 2770, Lans 2791,
 B KC 3123, Cong 3179, Maq. dol 3234,
 Viola 3329, Simp 3377, Arb. 3439

TD 3457

D&A

ABANDONED

County **Ellsworth** State **Kansas**

Sec. 20 (Blk.) 16 (Sur.) 8W Map No.

Operator Elreco & Rock Island

Well No. 1 Farm Hanley

Elev.	Location	SW	SW	SE
-------	----------	----	----	----

FIRST REPORT

330 Ft. From S Line SE

330 Ft. From W Line Quarter

1st. Report APR 15 1952

Completion

Remarks

Group Expl - Contr.


Spudding Date _____

Drig. Data Wildeat

Location _____

J. G. McGEHEE

County Ellsworth State Kansas
 Sec. 20 (Bk.) 16 (Sur.) 8W Map No.
 Operator Elreco & Rock Island
 Well No. 1 Farm Hanley
 Elev. 1733 Location SW SW SE

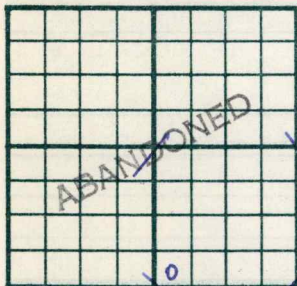

330Ft. From S Line SE
330Ft. From W Line Quarter
 1st. Report
 Completion APR 29 1953
 Remarks Wildcat
Group Expl. - Contr.
 Spudding Date 4-10-53

Drlg. Data D & A TD 3457

Heeb. 2655 Br. lime 2770 Lans. 2791

B KC 3123 Cong. 3179 Maq. dol. 3234

Viola 3329 Simp. 3377 Arb. 3439

TD 3457

D & A

J. G. McGEHEE