

KANSAS


FORM 51 5M 4-41 PETROL

Barton

Section 7 Township 16 Range 13-~~W~~

Well No. #4 Hoffman "B"

Company I.T.I.O.

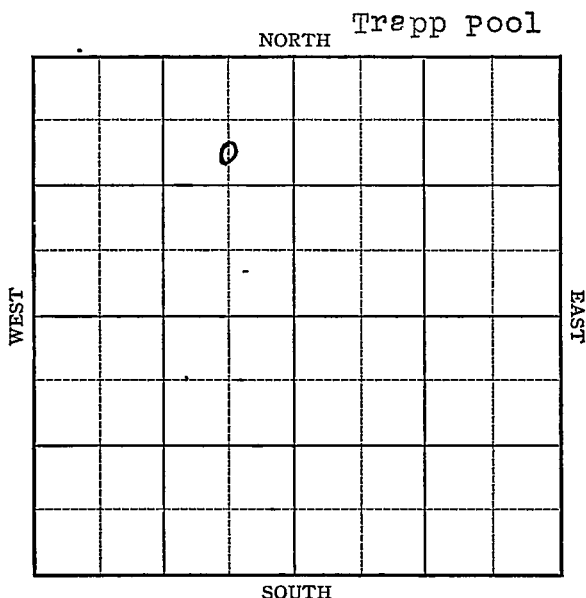

KANSAS


Barton

Sec. 7 Twp. 16 R. 13-WWell No. #4 Hoffman "B" FarmI.T.I.O.

(Trapp)

990 Ft. from N. Line Ft. from S. Line660 Ft. from E. Line Ft. from W. Line

Elev. 1916

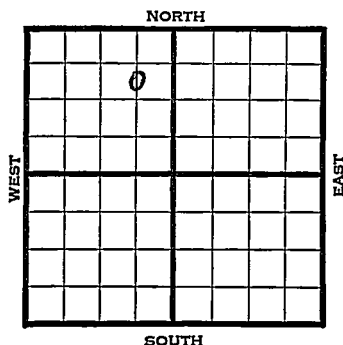

1941

REPORT

5/14

Derrick.

5/22

10" - 347' Drlg. 1580'

5/28

Drlg. 3130'

6/5

Drlg. 3210'

6/11

Arb. 3346'

7" - 3346'

T.D. 3356'

1000 acid.

Depthograph potential 4527 bbls.

Maximum 3000 bbls.

39. Gravity

COMPLETED

Map No. 73 Sec. 7 Twp. 16 R. 13WWell No. 4 Hoffman "B"I T I O CompanyFIRST REPORT Contractor

C S L NE NW

990 Ft. from N. Line Ft. from S. Line660 Ft. from E. Line Ft. from W. Line

SECTION PLAT

	o		

TRAPP POOL

Location Rig up

Drilling and Remarks:

Derrick

RECORD

Cased in., ft.Sand Gas Oil Total Depth

PRODUCTION

1st 24 hrs. Nat. 1st 24 hrs. after shot Gas Cu. Ft.Dry Hole Abandoned

Date

MAY 14 1941 19 S. J. LEWIS Scout

Map No. 73 Sec. 7 Twp. 16 R. 13WWell No. 4 Hoffman "B"

I T I O

Company

COMPLETED

Contractor

SECTION PLAT

C S L NE NW

	e		

990 Ft. from N. Line Ft. from S. Line660 Ft. from E. Line Ft. from W. Line

TRAPP POOL

Location Rig up

Drilling and Remarks:

*Cr 83346.**7" 83346**1000 acia C**Depth 84527**Max 3000**39 2 50*

RECORD

Cased in., ft.Sand Gas Oil Total Depth 3356

PRODUCTION

1st 24 hrs. Nat. 1st 24 hrs. after shot Gas Cu. Ft.Dry Hole Abandoned

Date

JUN 11 1941S. J. LEWIS

Scout