


Section 5 Township 16 Range 10-W

Well No. #2 Haska

Company Jayhawk Drlg. (Vickers)

NORTH Stoltenberg Pool

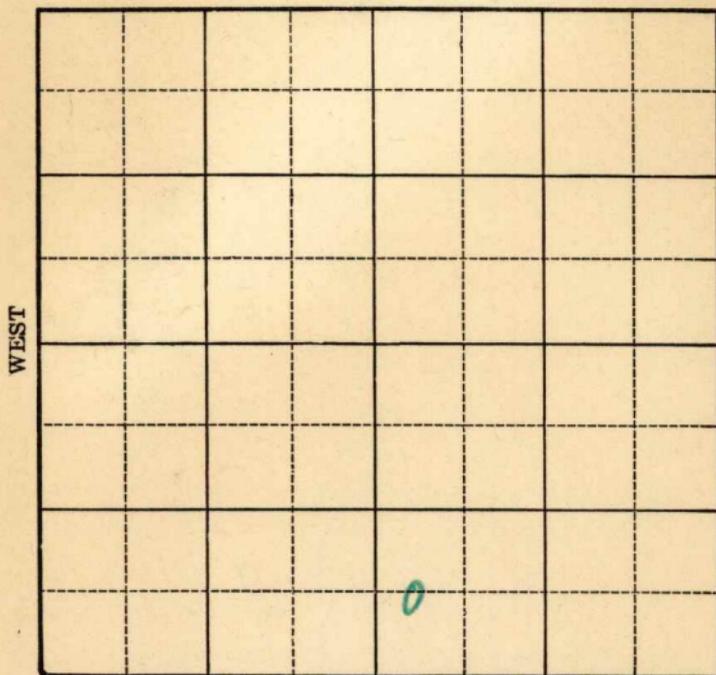

15

SOUTH

Sec. 5 Twp. 16 R. 10-W

Well No. #2 Haska Farm

Jayhawk Drlg. (Vickers) Company

(Stoltenberg)


\_\_\_\_\_ Ft. from N. Line

660 Ft. from S. Line

\_\_\_\_\_ Ft. from E. Line

330 Ft. from W. Line

**Elev. 1858**

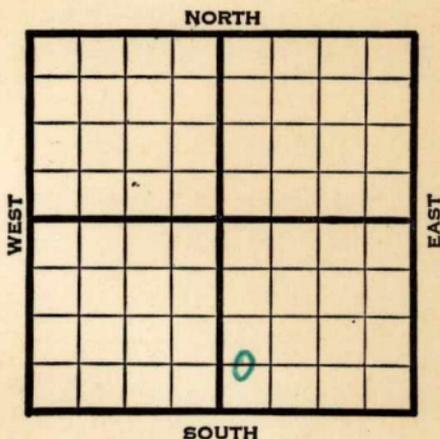

1940	REPORT
10/30	Derrick.
11/7	10" - 291' Drlg. 1585'
11/14	Lans. 2912' Drlg. 3050'
11/21	Arb. 3314' 5" - 3314'
	T.D. 3329' 1000 acid.
	Swab 25 bbls. per hour.
11/27	Reacidize.
12/4	Arb. 3314'
	5" - 3314'
	T.D. 3329'
	3000 acid.
	Potential 536 bbls., pump.
	45.4 Gravity
	<b>COMPLETED</b>

Map No. 55 Sec. 5 Twp. 16 R. 10W

Well No. 2 Haska

Jayhawk Drlg. (Vickers) Company

Contractor

FIRST REPORT

C W L SW SE

         Ft. from N. Line

660 Ft. from S. Line

         Ft. from E. Line

330 Ft. from W. Line

STOLTENBERG POOL

SECTION PLAT

		o	

Location                                 

Rig up                                 

Drilling and Remarks:

**Derrick**

RECORD

Cased                  in.,                  ft.

Sand                                 

Gas                                 

Oil                                 

Total Depth                                 

PRODUCTION

1st 24 hrs. Nat.                                 

1st 24 hrs. after shot                                 

Gas                                  Cu. Ft.

Dry Hole                                 

Abandoned                                 

Date

OCT 30 1940  
19

S. J. LEWIS Scout

Map No. 55 Sec. 5 Twp. 16 R. 10W

Well No. 2 Haska

Jayhawk Drilling (Vickers)  
Company

Contractor

**COMPLETED**

**SECTION PLAT**

C W L SW SE

\_\_\_\_\_ Ft. from N. Line

660 Ft. from S. Line

\_\_\_\_\_ Ft. from E. Line

330 Ft. from W. Line

STOLTENBERG POOL

		0	

Location \_\_\_\_\_

Rig up \_\_\_\_\_

Drilling and Remarks:

*Ar 83314*  
*5" C 3314*  
*3000 acid*  
*Pump 536 P.D.*  
*45 4/22.*

**RECORD**

Cased \_\_\_\_\_ in., \_\_\_\_\_ ft.

Sand \_\_\_\_\_

Gas \_\_\_\_\_

Oil \_\_\_\_\_

Total Depth 3329

**PRODUCTION**

1st 24 hrs. Nat. \_\_\_\_\_

1st 24 hrs. after shot \_\_\_\_\_

Gas \_\_\_\_\_ Cu. Ft.

Dry Hole \_\_\_\_\_

Abandoned \_\_\_\_\_

Date

DEC 4 1940

S. J. LEWIS Scout