


Section 15 Township 16 Range 8W

Well No. #1 Westerman

Company Coffman, Blair & Ward

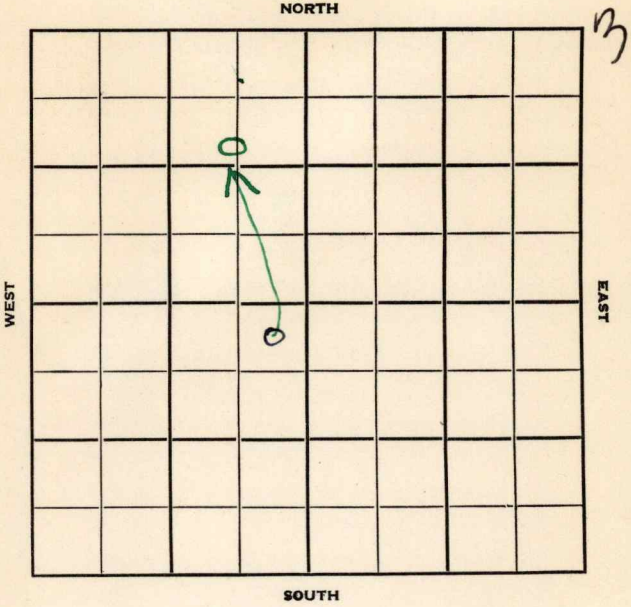

KANSAS

Ellsworth

Sec. 15 Twp. 16 R. 8 W

Well No. # 1 Westerman Farm

Coffman, Blair & Ward Company

Contractor


Wildcat

990
330 Ft. from N. Line

Ft. from S. Line

660
330 Ft. from E. Line

Ft. from W. Line

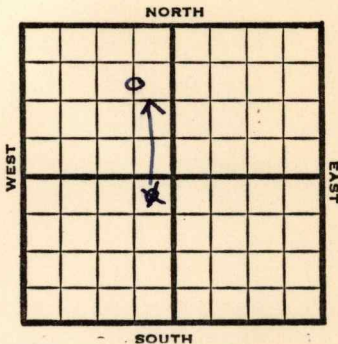

CSL NE NW
NE NE SW

1952

Elev. 1577'

REPORT

1/9

Spud 12-29-51

8" @ 157'

DST 2546-67' 1/2 hr. 150' SW plus SSO

KC 2573' SO 2700-07'

To DST

1/16

Spud 12-29-51

D&A TD 3070

8" @ 157' DST 2546-67 open 1/2 hr.

rec. 150' SW SSO KC 2573

DST 2820-42 open 1/2 hr. rec. 9' SW

Arb. 2971 TD 3070

D&A

ABANDONED

County **Ellsworth** State **Kansas**

Sec. **15** (Blk. Twp.) **16** (Sur. Rge.) **8W** Map No.

Operator **Coffman, Blair & Ward**

Well No. **1** Farm **Westerman**

Elev. Location **NE NE SW**

| | | | |
|---------------------|---|--|--|
| FIRST REPORT | | | |
| | | | |
| | | | |
| | | | |
| | 0 | | |
| | | | |
| | | | |
| | | | |

330 Ft. From **N** Line **SW**

330 Ft. From **E** Line **Quarter**

Ist. Report **JAN 9 1952**

Completion

Remarks

be corrected

Spudding Date **12-29-51**

Drlg. Data **Wildcat**

8" @ 157 DST 2546-67 1/2 hr. 150' SW plus
SSO KC 2573 SO 2700-07 to DST

J. E. TYRA

Map No. _____ Sec. 15 Twp. 16 R. 8W

Well No. 1 Westerman

Kaufman, Blair & Ward Company

CORRECTION Contractor

C S L NE NW

SECTION PLAT

990 Ft. from N. Line

_____ Ft. from S. Line

660 Ft. from E. Line

_____ Ft. from W. Line

| | | | |
|--|---|--|--|
| | 0 | | |
| | | | |
| | | | |
| | | | |
| | | | |

Ellsworth County

Location _____

Rig up _____

Drilling and Remarks:

Reported

NE NE SW

RECORD

Cased _____ in., _____ ft.

Sand _____

Gas _____

Oil _____

Total Depth _____

PRODUCTION

1st 24 hrs. Nat. _____

1st 24 hrs. after shot _____

Gas _____ Cu. Ft.

Dry Hole _____

Abandoned _____

Date

JAN 9 1952 19

J. E. TYRA Scout

County Ellsworth State Kansas

Sec. 15 (Blk. 16) (Sur. 8W) (Twp. 16) (Rge. 8W) Map No.

Operator Coffman, Blair & Ward

Well No. 1 Farm Westerman

Elev. 1577 Location C S L NE NW



990 Ft. From N Line NW

660 Ft. From E Line Quarter

Ist. Report

Completion JAN 16 1952

Remarks Wildcat

Spudding Date 12-29-51

Drlg. Data D & A TD 3070

8" @ 157 DST 2546-67 open $\frac{1}{2}$ hr.

Rec. 150' sw SSO KC 2573 DST 2820-42

open $\frac{1}{2}$ hr. Rec. 9' sw Arb. 2971

TD 3070 D & A

J. E. TYRA