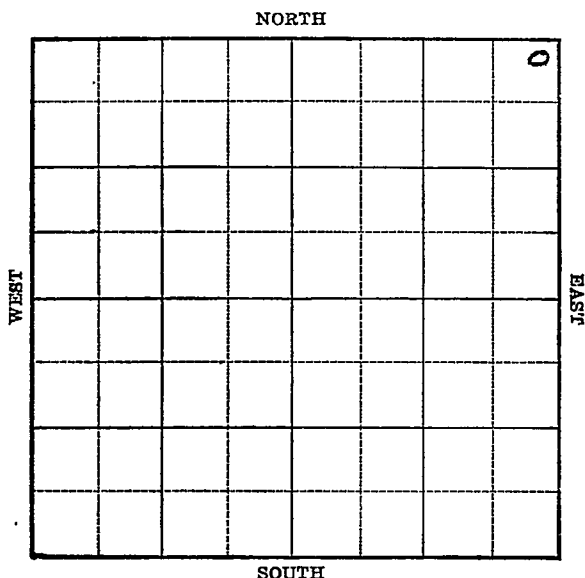


Section 7 Township 16 Range 13-WWell No. 4 HoffmanCompany Sinclair-Prairie

Barton **KANSAS**Map No. 73 Sec. 7 Twp. 16 R. 13WWell No. 4 HoffmanSinclair Prairie CompanyContractor**FIRST REPORT****SECTION PLAT****NE/C**330 Ft. from N. Line Ft. from S. Line330 Ft. from E. Line Ft. from W. Line

			0

Location Rig up

Drilling and Remarks:

BRR**RECORD**Cased in., ft. →Sand Gas Oil Total Depth **PRODUCTION**1st 24 hrs. Nat. 1st 24 hrs. after shot Gas Cu. Ft.Dry Hole Abandoned

Date

NOV 16 193819**H. D. Hatfield** Scout

Barton

KANSAS

Map No. 73 Sec. 7 Twp. 16 R. 13WWell No. 4 HoffmanSinclair Prairie

Company

Contractor

~~COMPLETED~~

SECTION PLAT

NE/C

330 Ft. from N. Line Ft. from S. Line330 Ft. from E. Line Ft. from W. LineTRAPP, ARBUCKLE
POOL

			0

Location Rig up

Drilling and Remarks:

*2000 acid**P- 796/8**POT 2388**NO WTR*

RECORD

Cased 7 in., 3353 ft.Sand Arb 3353Gas Oil Total Depth 3365

PRODUCTION

1st 24 hrs. Nat. 1st 24 hrs. after shot Gas Cu. Ft.Dry Hole Abandoned

Date

E. D. Hatfield

DEC 21 1938

19

Scout