


KANSAS

Section 5 Township 16 Range 10-W

Well No. #2, Horeji

Company Sohio

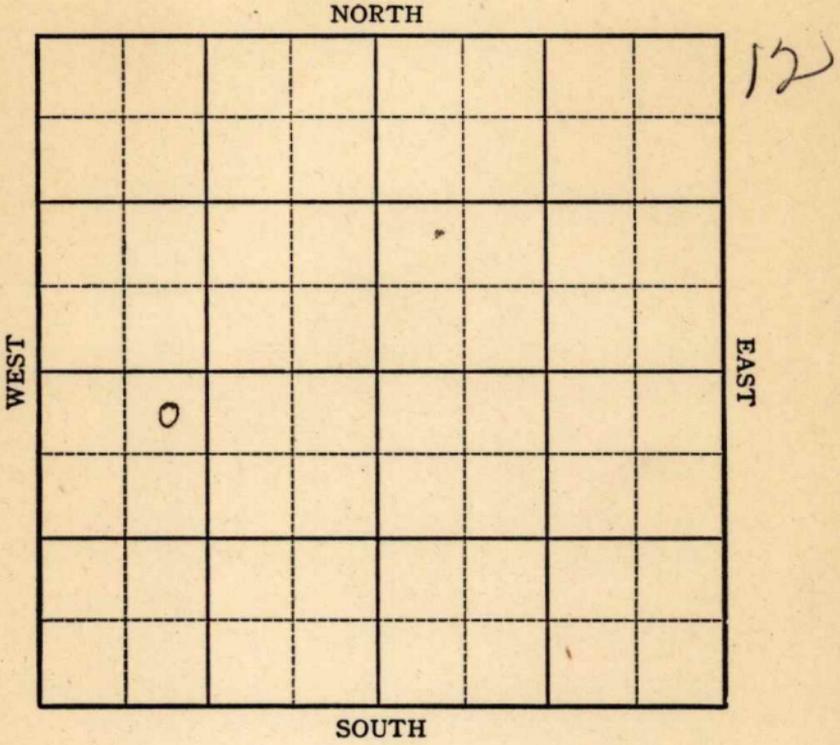

Sec. 5 Twp. 16 R. 10W

Well No. #2 Horeji Farm

Sohio Company


Bloomer

330 Ft. from N. Line

Ft. from S. Line

Ft. from E. Line

990 Ft. from W. Line

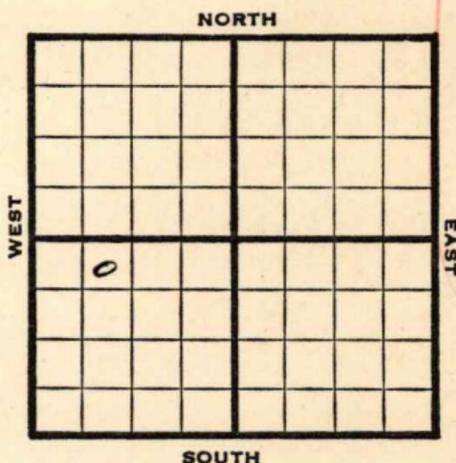

NE NW SW

1946

1797

REPORT

9/25 Location

10/1 RUR

10/8 8" @ 288
Drlg 1695'

10/15 Drlg 3235'

10/22 Arb 3278-83 TD
5" @ 3279, RUST

10/30 Arb 3278'
5" @ 3279'
TD 3291'

ABANDONED

KANSAS

Kansas Pool Name Bloomer

Map No. 55 Sec. 5 Twp. 16 R. 10W

Well No. 2 Horeji

Sohio Company

FIRST REPORT Contractor

NE NW SW

SECTION PLAT

330 Ft. from N. Line

_____ Ft. from S. Line

_____ Ft. from E. Line

990 Ft. from W. Line

o			

Ellsworth County

Location X

Rig up _____

Drilling and Remarks:

RECORD

Cased _____ in., _____ ft.

Sand _____

Gas _____

Oil _____

Total Depth _____

PRODUCTION

1st 24 hrs. Nat. _____

1st 24 hrs. after shot _____

Gas _____ Cu. Ft.

Dry Hole _____

Abandoned _____

Date

SEP 25 1946 19 _____

S. J. LEWIS Scout

Kansas

Map No. 25 Sec. 5 Twp. 16 R. 10W

Well No. 2 Hereji

Sohio Company

ABANDONED Contractor

NE NW SW

511799
SECTION PLAT

330 Ft. from N. Line

_____ Ft. from S. Line

_____ Ft. from E. Line

990 Ft. from W. Line

0			

Ellsworth County

Location _____

Rig up _____

Drilling and Remarks:

CR 8278

5' @ 8279

RECORD

Cased _____ in., _____ ft.

Sand _____

Gas _____

Oil _____

Total Depth 829'

PRODUCTION

1st 24 hrs. Nat. _____

1st 24 hrs. after shot _____

Gas _____ Cu. Ft.

Dry Hole _____

Abandoned _____

Date

OCT 30 1946

19

S. J. LEWIS

Scout