

O.W.W.O.

FORM 51 25M 3-49 PETROL

KANSAS

Ellsworth

Section 5 Township 16 Range 10W

Well No. ~~1 Vacek~~ #2 Vacek "B"


Company J. G. Dozier Grant Oil

Stoltenberg
NORTH

8

WEST

EAST

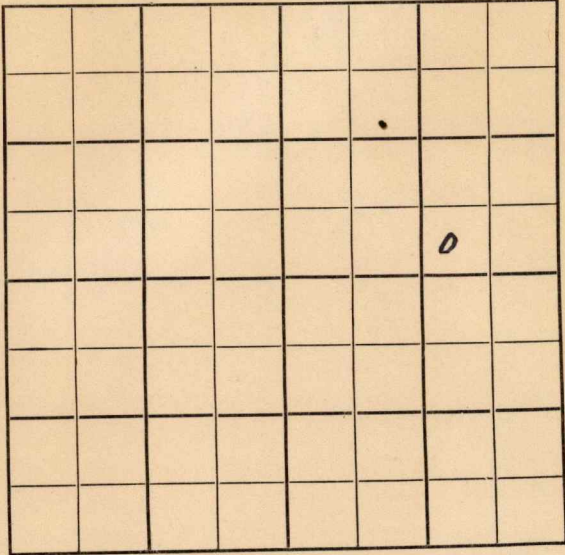

SOUTH

O.W.W.O.

Ellsworth

KANSAS

Sec. 5 Twp. 16 R. 10W

Well No. #1 Vacek #2 Vacek "B" Farm

J. C. Dozier Grant Oil Company


Stoltenberg Pool (Sterling Drlg., Cont.)
NORTH

_____ Ft. from N. Line

330' Ft. from S. Line

990' Ft. from E. Line

_____ Ft. from W. Line

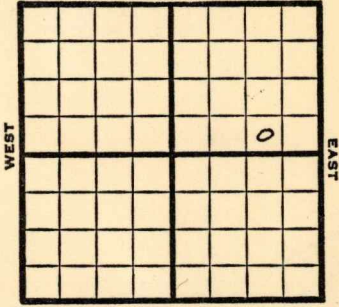

SW SE NE

1949 **Elev 1836'** REPORT

7/6 8" @ 186'
 Anhy. 635'
 Drlg. 2460'

7/13 TD 3327'
 Arb. 3325'
 Aband.

ABANDONED

~~###~~

1956
O.W.W.O.

6-27 Location

7-25 CO 3326
 S/ 3/4 BOPH, nw, 4 hrs.
 P/ 25 bopd, no/wtr.
 Anhy. 635'; L. 2970'; A. 3324';
 TD 3327'

COMPLETED

County Ellsworth Elev. 1836
 Sec. 5 Twp. 16 Rge. 10W
 Company Grant Oil
 Farm Name Vacek "B" No. 2

TOPS	DEPTH	LOG	DATUM	Loc. in Sec.
Anh.	635			SW SE NE
Tr.				
Dg.				
Bl.				
L.	2970			Geol.
K.C.				Contr.
B.M.C.				Walters
Ce.				Pool
C.				Stoltenberg
M.				COMPLETE
N.				
K.				JUL 25 1956
Mz.				
Ma.				
V.				
S.				
S.				
A.	3324			
R.				
PE.				
G.				
TR.	3327			

Date Comm.

Location JUL 3 '56 ✓ JUL 11 '56 CO 3326

634 Bopk no/wtr 4 hrs JUL 18 '56

Pop. JUL 25 '56 P. 25 Bopd no/w

Co.

Lse.

No.

Sec.

T.

R.

Map No. _____ Sec. 5 Twp. 16 R. 10W

Well No. 1 Vacek or 2 vacch "B" 166510HL

J. C. Dozier Grant Oil Company

Sterling Drlg. Contractor

SW SE NE

FIRST REPORT
SECTION PLAT

_____ Ft. from N. Line

330 Ft. from S. Line

990 Ft. from E. Line

_____ Ft. from W. Line

Ellsworth County

Location _____

Rig up _____

Drilling and Remarks:

8" @ 186

Anhy 635

drlg. 2460

RECORD

Cased _____ in., _____ ft.

Sand _____

Gas _____

Oil _____

Total Depth _____

PRODUCTION

1st 24 hrs. Nat. _____

1st 24 hrs. after shot _____

Gas _____ Cu. Ft.

Dry Hole _____

Abandoned _____

Date

JUL 6 1949 19

S. J. LEWIS Scout

Kansas

Map No. K 55 Sec. 5 Twp. 16 R. 10W

Well No. 1 Vacek or 2 Vacek 'B' 1651011

J. C. Dozier Grant Oil Company

ABANDONED

Contractor

SW SE NE

E. 1886

SECTION PLAT

_____ Ft. from N. Line

330 Ft. from S. Line

990 Ft. from E. Line

_____ Ft. from W. Line

Ellsworth County

Location _____

Rig up _____

Drilling and Remarks:

see 3325

RECORD

Cased _____ in., _____ ft.

Sand _____

Gas _____

Oil _____

Total Depth 3327

PRODUCTION

1st 24 hrs. Nat. _____

1st 24 hrs. after shot _____

Gas _____ Cu. Ft.

Dry Hole _____

Abandoned _____

Date

JUL 13 1949 19

S. J. LEWIS Scout