

KANSAS

Section 5 Township 16 Range 10W

Well No. 3 Adamek

Company Sohio et al

Stoltenberg
NORTH

			0				

SOUTH

WEST

EAST

6

KANSAS

Ellsworth

Sec. 5 Twp. 16-S15 R. 10W ✓

Well No. #3 Adamek Farm

Sohio et al

Company

Stoltenberg Pool


 Ft. from N. Line

990' Ft. from S. Line

330' Ft. from E. Line

 Ft. from W. Line

NE SE NW

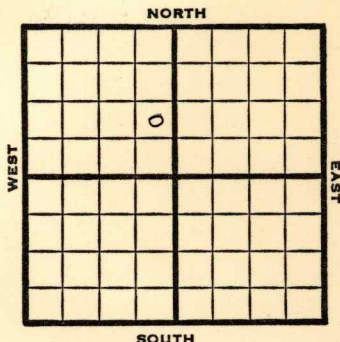

1949

Elev 1792'

R E P O R T

2/23

RUR

3/2

8"@ 315'

Drlg 1900'

3/8

Lansing 2952'

Arbuckle 3281-85'

TD 3285'

5"@ 3282'

3/16

500 acid

3/23

TD 3285'

Arb. 3281'

Aband.

ABANDONED

Map No. _____ Sec. 5 Twp. 16 R. 10WWell No. 3 AdamekSohio etal. CompanyFIRST REPORT Contractor

NE SE NW

SECTION PLAT

	o		

_____ Ft. from N. Line

990 Ft. from S. Line330 Ft. from E. Line

_____ Ft. from W. Line

Ellsworth County

Location _____

Rig up _____

Drilling and Remarks:

R U R

RECORD

Cased _____ in., _____ ft.

Sand _____

Gas _____

Oil _____

Total Depth _____

PRODUCTION

1st 24 hrs. Nat. _____

1st 24 hrs. after shot _____

Gas _____ Cu. Ft.

Dry Hole _____

Abandoned _____

Date

FEB 23 1949 19S. J. LEWIS Scout

Kansas

Map No. 55 Sec. 5 Twp. 16 R. 10WWell No. 3 Adamek

Sohio et al.

Company

ABANDONED

Contractor

NE SE NW

E 11792
SECTION PLAT

	0		

Ft. from N. Line

990

Ft. from S. Line

330

Ft. from E. Line

Ft. from W. Line

Ellsworth County

Location

Rig up

Drilling and Remarks:

Cen 48281

RECORD

Cased _____ in., _____ ft.

Sand _____

Gas _____

Oil _____

Total Depth 3285

PRODUCTION

1st 24 hrs. Nat. _____

1st 24 hrs. after shot _____

Gas _____ Cu. Ft.

Dry Hole _____

Abandoned _____

Date

MAR 23 1949 19

S. J. LEWIS

Scout