

KANSAS

Form 51-5M-11-38-Palace


Russell O. W. P. B.

Section 9 Township 15 Range 13-W

Well No. #4 Roesner

Company Stanolind

NORTH Coralena Pool

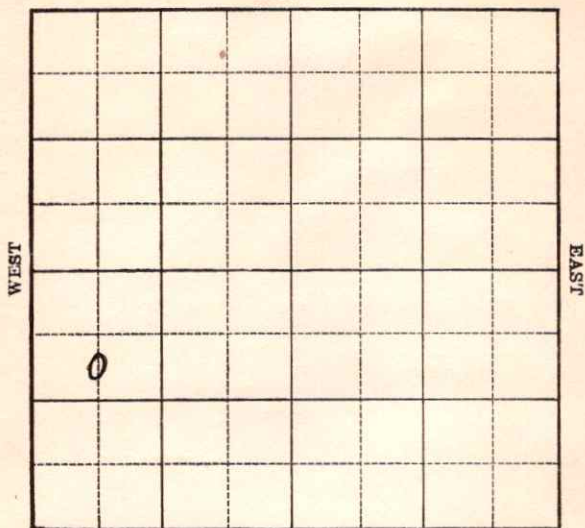

SOUTH

1939
12/6

Lans. 3054'
7" - 3057'
T.D. 3153'
P.B. 3149'
4100 acid.
Pump 525 oil,
trace of water.

COMPLETED

O. W. P. B.

1953
9/23

Oil Well
TD 3153'
Tarkio 2420, KC 3054,
OTD 3153
7" @ 3057
SP 2530
Perf 2505-06, 12/2420-23, 8/2434-36,
B/47 go 1 hrs., multi-frac
P/66 bopd 4 bw dec.
Comp. 4 bopd 5 bw

FIRST REPORT

&

COMPLETED

Russell

KANSAS

Map No. 73 Sec. 9 Twp. 15 R. 13WWell No. 4 Roesner

Stanolind

Company

Contractor

FIRST REPORT

SECTION PLAT

C $S\frac{1}{2}$ NW SW
990 Ft. from N. Line Ft. from S. Line Ft. from E. Line660 Ft. from W. Line

o			

CORALENA POOL

Location XRig up

Drilling and Remarks:

RECORD

Cased in., ft.Sand Gas Oil Total Depth

PRODUCTION

1st 24 hrs. Nat. 1st 24 hrs. after shot Gas Cu. Ft.Dry Hole Abandoned

Date

SEP 20 1939 19

S. J. LEWIS

Scout

Map No. 73 Sec. 9 Twp. 15 R. 13WWell No. 4 RoesnerStanolind

Company

Contractor

COMPLETED

C S $\frac{1}{2}$ NW SW

SECTION PLAT

990 Ft. from N. Line

_____ Ft. from S. Line

_____ Ft. from E. Line

660 Ft. from W. Line

CORALENA POOL

Location _____

Rig up _____

Drilling and Remarks:

*Lease 3054**7" C 3057**P.B 3149**4100 acid**Pump 525 oil**trace water.*

RECORD

Cased _____ in., _____ ft.

Sand _____

Gas _____

Oil _____

Total Depth 3153

PRODUCTION

1st 24 hrs. Nat. _____

1st 24 hrs. after shot _____

Gas _____ Cu. Ft.

Dry Hole _____

Abandoned _____

Date

DEC 6 1939 19

S. J. LEWIS Scout

