

KANSAS

Russell


Form 51-5M-7-39-Palace

Section 9 Township 15 Range 13-W

Well No. #6 Roesner

Company Stanolind

NORTH Coralena Pool

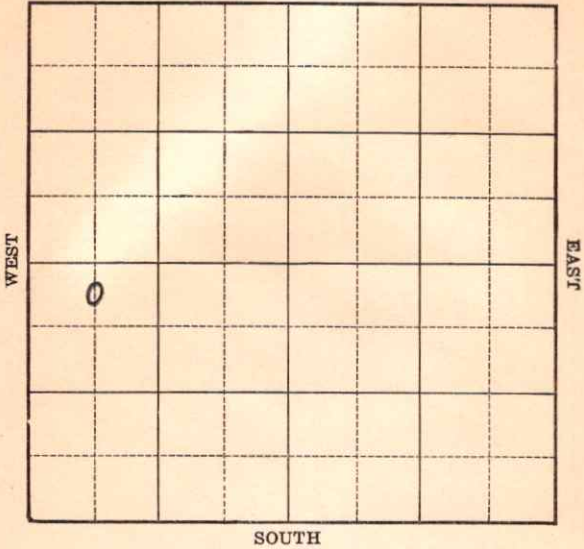

O.W.W.O.

Sec. 9 Twp. 15 R. 13-W

Well No. #6 Roesner Farm

Stanolind Company


(Coralena)

330 Ft. from N. Line

_____ Ft. from S. Line

_____ Ft. from E. Line

660 Ft. from W. Line

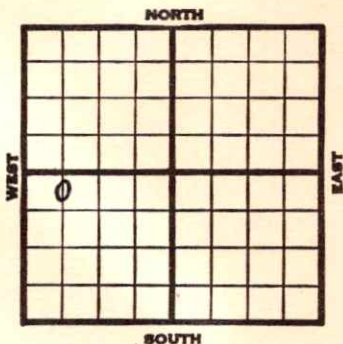

Elev. 1871

1940	REPORT
1/10	10" - 604' WOC - 650'
1/18	Anhy 823' Drlg. 2083'
1/25	Coring 2934'
2/1	Lans. 2915' Coring 3285'
2/8	Arb. 3315' 7" - 3315'
	T.D. 3321' SSO C.O.
2/15	T.D. 3325' 2000 acid.
	Pump 613 bbls. 24 hours.
2/21	Arb. 3315'
	7" - 3315'
	T.D. 3325'
	2000 acid.
	50 shots 3311-15'
	Potential 613 bbls., on pump.
	COMPLETED
1950	O.W.W.O.
9/20	TD 3325
	Arb 3315-25 PB to Lans 7" @ 3315
	CO to 3325 P/33 bo 51 bwpd
	Completed FIRST REPORT

COMPLETED

Map No. 73 Sec. 9 Twp. 15 R. 13WWell No. 6 RoesnerStanolind

Company _____

Contractor _____

FIRST REPORT

C $N\frac{1}{2}$ NW SW330 Ft. from N. Line

_____ Ft. from S. Line

_____ Ft. from E. Line

660 Ft. from W. Line

SECTION PLAT

o			

CORALENA POOL

Location _____

Rig up _____

Drilling and Remarks:

10" - 604

WOC - 650

RECORD

Cased _____ in., _____ ft.

Sand _____

Gas _____

Oil _____

Total Depth _____

PRODUCTION

1st 24 hrs. Nat. _____

1st 24 hrs. after shot _____

Gas _____ Cu. Ft.

Dry Hole _____

Abandoned _____

Date

JAN 10 1940

19

S. J. LEWIS

Scout

Map No. 73 Sec. 9 Twp. 15 R. 13WWell No. 6 RoesnerStanolind Company

Contractor

COMPLETED

C $N\frac{1}{2}$ NW SW330 Ft. from N. Line

_____ Ft. from S. Line

_____ Ft. from E. Line

660 Ft. from W. Line

SECTION PLAT

o			

CORALENA POOL

Location _____

Rig up _____

Drilling and Remarks:

Cu 83315-
7" @ 3315-
2000 acid
50 Skts 3311-15-
Pump 613 Pst.

RECORD

Cased _____ in., _____ ft.

Sand _____

Gas _____

Oil _____

Total Depth 3325-

PRODUCTION

1st 24 hrs. Nat. _____

1st 24 hrs. after shot _____

Gas _____ Cu. Ft.

Dry Hole _____

Abandoned _____

Date

FEB 21 1940

19

S. J. LEWIS Scout

County Russell State KansasSec. 9 (Blk. 15) (Sur. 13W) (Twp.) (Rge.) Map No.Operator StanolindWell No. 6 Farm RoesnerElev. 1871 Location C N L NW SW

330 Ft. From N Line SW660 Ft. From W Line Quarter1st. Report SEP 20 1950Completion SEP 20 1950

Remarks

O. W. P. B.

Spudding Date

Drlg. Data Oil well TD 3325 Trapp PoolArb. 3315-25 PB to Lans. 7" @ 3315CO to 3325 P/ 33 bo 51 bwpd Comp.

J. E. TYRA