

KANSAS

O.W.W.O.
FORM 513M 4-21 PETROL


Barton

KANSAS

Section 7 Township 16 Range 13-W

Well No. 7 Hoffman

Company Sinclair ~~Prairie~~ Oil & Gas

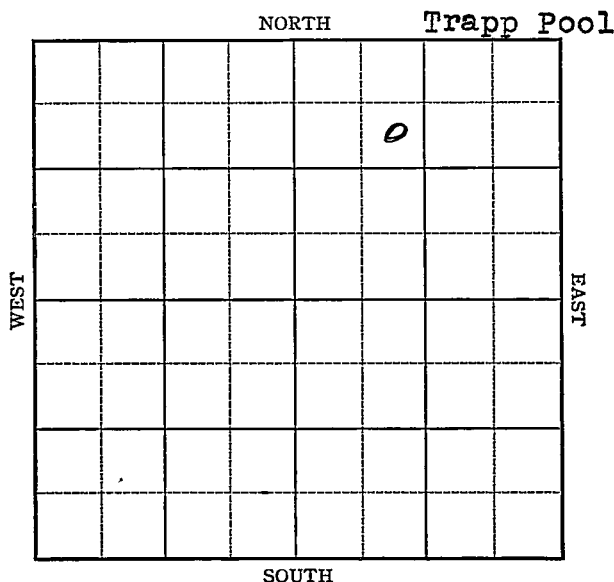


Sec. 7 Twp. 16 R. 13-WWell No. #7 Hoffman FarmSinclair - Prairie Company

(Trapp)

990 Ft. from N. Line Ft. from S. Line Ft. from E. Line990 Ft. from W. Line

SE-NW-NE

Elev. 1925

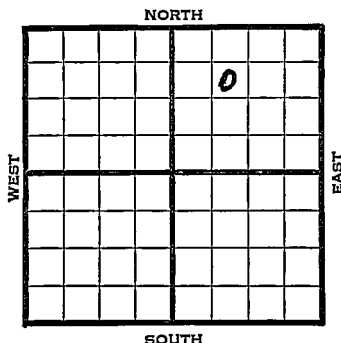

1941	REPORT
4/23	Location
5/1	"
5/8	Rotary.
5/15	13" - 199' Drlg. 2000'
5/22	Drlg. 3260'
5/28	8" - 3360' RUST.
6/4	Arb. 3358½'
	8" - 3360'
	T.D. 3364½'
	1000 acid.
	Depthograph potential 31,189 bbl
	Maximum 3000 bbls.
	39.13 Gravity
	COMPLETED
1955	O.W.W.O.
11/30	OTD 3364' 5" @ 3361 PB 3360
	12/3358-59 50 A 17 GO 33 GWPH
	100 A wtr. PB 3160 16/3124-28
	S/52 BWPH 6 hr. D & A
	Tp 2813', H 3042', Tr. 3058', L 3113'
	BKG 3318', A 3357', TD 3364'
	D & A FIRST REPORT ABANDONED

Map No. 73 Sec. 7 Twp. 16 R. 13WWell No. 7 HoffmanSinclair Prairie

Company

FIRST REPORT

Contractor

SE NW NE

SECTION PLAT

		o	

990 Ft. from N. Line Ft. from S. Line Ft. from E. Line990 Ft. from W. Line

TRAPP POOL

Location XRig up

Drilling and Remarks:

RECORD

Cased in., ft.Sand Gas Oil Total Depth

PRODUCTION

1st 24 hrs. Nat. 1st 24 hrs. after shot Gas Cu. Ft.Dry Hole Abandoned

Date

APR 23 1941

19

S. J. LEWIS Scout

Map No. _____ Sec. 7 Twp. 16 R. 13WWell No. 7 HoffmanSinclair Prairie

Company _____

COMPLETED

Contractor _____

SE NW NE

990 Ft. from N. Line

_____ Ft. from S. Line

_____ Ft. from E. Line

990 Ft. from W. Line

TRAPP POOL

SECTION PLAT

Location _____

Rig up _____

Drilling and Remarks:

*Cr X 3358 1/2**5" @ 3360**1000 acid**Dep't # 31189**Max 3000**39 3/4*

RECORD

Cased _____ in., _____ ft.

Sand _____

Gas _____

Oil _____

Total Depth *3364 1/2*

PRODUCTION

1st 24 hrs. - Nat. _____

1st 24 hrs. after shot _____

Gas _____ Cu. Ft.

Dry Hole _____

Abandoned _____

Date

JUN 4 1941S. J. LEWIS

Scout

O.W.W.O.

FORM 513 REV. SUNRAY

O.W.O.

County Barton Elev. 13W
 Sec. 7- Twp. 16 Rge. 13W
 Company Sinclair Oil & Gas
 FarmName Hoffman No. 7

Co.

Lse.

Sec.

T.

R.

TOPS DEPTH LOG DATUM

Anh.			
TP.	2813		
H.	3012		
Tr.	3058		
Dg.			
BL.			
L.	3113		
K.C.			
B.K.C.	3318		
Ce.			
C.			
M.			
M.			
K.			
Mz.			
Ma.			
V.			
S.			
S.			
A.	3357		
R.			
Pe.			
G.			
T.D.	3361		

Loc. in Sec. SE NW NE

Geol.

Contr.

Pool

Trapp

NOV 30 '55

FIRST REPORT

ABANDONED

Date Comm.

OTD 3361 5" @ 3361 PB 3360

12/ 3358-59 50 A 17 go 33 gwph

100 A wtr. PB 3160 16/ 3124-28

S/ 52 bwph 6 hr.

D & A