


Ellsworth

KANSAS

SECTION 5 TOWNSHIP 16 RANGE 10W

WELL NO. #4 Haska

COMPANY Sohio Petroleum

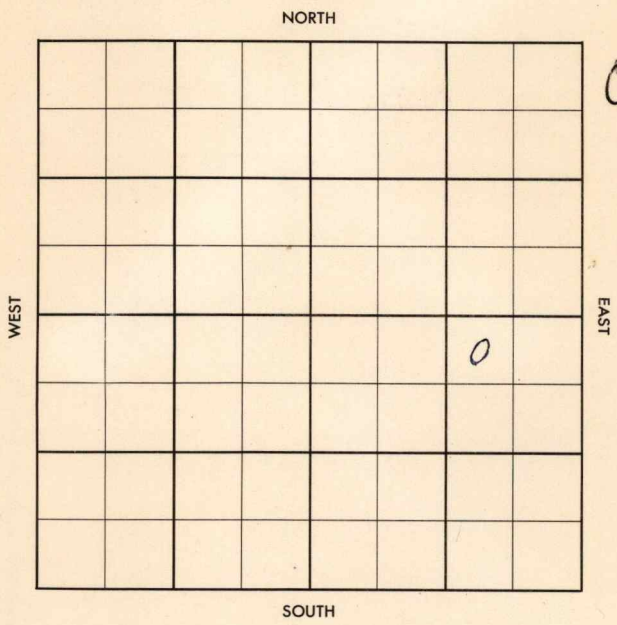


County Ellsworth Elev. _____
 Sec. 5 Twp. 16 Rgs. 10W
 Company Sohio Petroleum
 Farm Name Haska No. 4

TOPS	DEPTH	LOG	DATUM	Loc. in Sec.
Anh.				NW NE SE
TP.				
H.	2869			
Tr.				
Dg.				
Bl.	2969			
L.	2985			
K.C.				Geol. _____
B.K.C.				Contr. _____
Ce.				A. L. Jackson Pool
C.				
M.				
M.				Pool
K.				Stoltenberg
Mz.				
Mo.				
V.				
S. <u>sd</u>	3300			COMPLETE
S.				
A.	3326			
R.				
PE.				
G.				
T.D.	3336			JAN 16 '57

Date Comm. 12-18-56
8" @ 361, DST 3076-81, open 1 hr, 55' oil
mud, 55' SW, FPO-46, BHP 1020#/20, Drlg. 314
JAN 2 '57 DST 3328-35 1hr 165'
GSSY oil + 20' MO BHP 1020/20
5 1/2 3335^{1/2}/100 JAN 9 '57 CO 3336
\$ 9.87 Bo no/w in 5 hrs
Pop. JAN 10 '57 P. 77 Bo no/w
15 hrs P. 32 Bopd no/w
complete

County Ellsworth Elev. _____
 Sec. 5 Twp. 16 Rge. LOW
 Company Sonio Petroleum
 Farm Name Haska No. 4

TOPS	DEPTH	LOG	DATUM	Loc. in Sec.
Anh.				NW NE SE
Tr.	2869			
H.				
Tr.				
Dg.				
Bl.	2969			
L.	2985			
K.C.				Geol. _____
B.K.C.				Contr. _____
Ce.				A.L. Jackson Twp.
C.				
M.				Pool Stoltenberg
M.				
K.				
Mz.				
Mq.				
V.				
S.				
S.				
A.				
R.				
Pe.				
G.				
T.D.				FIRST REPORT

Date Comm. 12-18-56
8" @ 361, DST 3076-81, open 1 hr, 55' oil
mud, 55' SW, FPO-46, BHP 1020#/20, Drlg. 3141

~~12~~