

KANSAS

Form 51—5M—7-39—Palace


Russell

Section 9 Township 15 Range 13-W

Well No. #5 R. Rosener

Company Stanolind

NORTH Coralena Pool

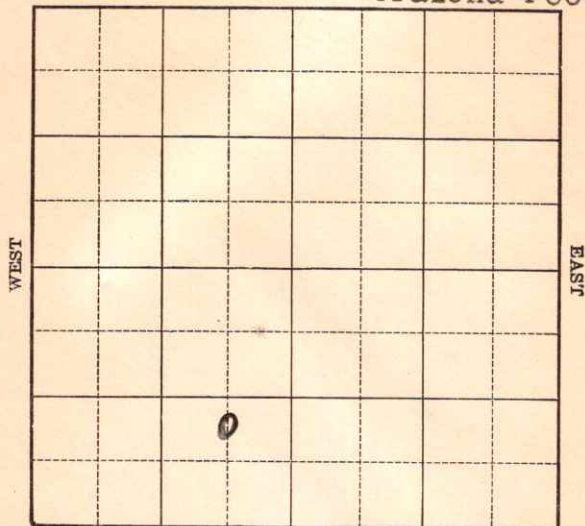

SOUTH

KANSAS

Russell

Sec. 9 Twp. 15 R. 13-WWell No. #5 R. Rosener FarmStanolind Company

(Coralena)

Ft. from N. Line


990

Ft. from S. Line

660

Ft. from E. Line

Ft. from W. Line

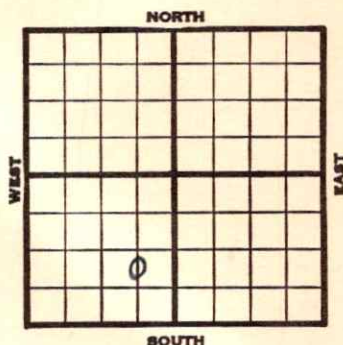

1939	REPORT
10/4	Location
10/12	"
10/19	Cable rig.
10/26	20" - 40' 16" - 252'
	Drlg. 445'
11/2	Drlg. 650'
11/9	Anhy 824' 10" - 828'
	Drlg. 1595'
11/16	Tarkio 2404' S.O. Run 8".
11/23	Drlg. 2945'
11/29	Lans. 3024' 7" - 3042' RUST.
12/6	Lans. 3024'
	7" - 3042'
	T.D. 3065'
	8000 acid.
	Potential 2004 bbls., pump.
	COMPLETED

Russell

KANSAS

Map No. 73 Sec. 9 Twp. 15 R. 13WWell No. 5 R. RosenerStanolind

Company

Contractor

COMPLETED

C $N\frac{1}{2}$ SE SW

Ft. from N. Line

990 Ft. from S. Line660 Ft. from E. Line

Ft. from W. Line

SECTION PLAT

	o		

CORALENA POOL

Location

RECORD

Cased _____ in., _____ ft.

Sand _____

Gas _____

Oil _____

Total Depth 3065

PRODUCTION

1st 24 hrs. Nat. _____

1st 24 hrs. after shot _____

Gas _____ Cu. Ft.

Dry Hole _____

Abandoned _____

Rig up _____
Drilling and Remarks:*Lane 3024**7" @ 3042**10000 ad**Pump 2004 P.D.*

Date

DEC 6 1939 19

S. J. LEWIS Scout

Map No. 73 Sec. 9 Twp. 15 R. 13WWell No. 5 R. Rosener

Stanolind

Company

Contractor

FIRST REPORT

C N $\frac{1}{2}$ SE SW

SECTION PLAT

Ft. from N. Line

990 Ft. from S. Line660 Ft. from E. Line

Ft. from W. Line

CORALENA POOL

Location X

Rig up

Drilling and Remarks:

RECORD

Cased _____ in., _____ ft.

Sand _____

Gas _____

Oil _____

Total Depth _____

PRODUCTION

1st 24 hrs. Nat. _____

1st 24 hrs. after shot _____

Gas _____ Cu. Ft.

Dry Hole _____

Abandoned _____

Date

OCT 4 1939 19

S. J. LEWIS

Scout