

KANSAS

Form 51—5M—7-39—Palace


Russell

Section 9 Township 15 Range 13-W

Well No. #1 Roesner

Company Phillips

NORTH Coralena Pool

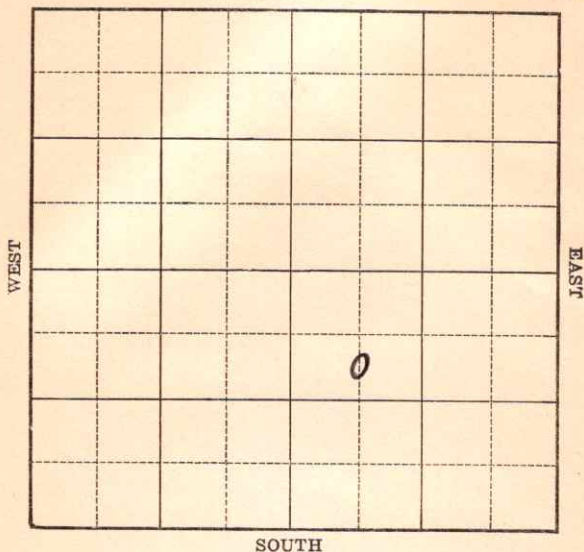

KANSAS

Russell

Sec. 9 Twp. 15 R. 13-WWell No. #1 Roesner FarmPhillips Company

(Coralena)


990 Ft. from N. Line

Ft. from S. Line

Ft. from E. Line

660 Ft. from W. Line

Elev. 1844

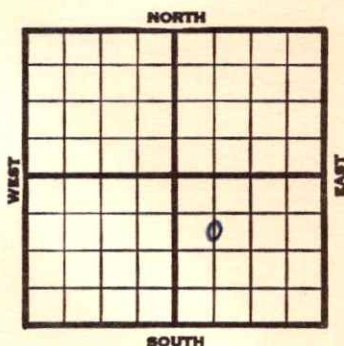

1940	REPORT
1/17	Location
1/25	"
2/1	Rigging up rotary.
2/8	" " "
2/15	10" - 577' WOC.
2/23	Drlg. 1930'
2/29	Drlg. 2795'
3/8	Lansing 3009' Core 3029-35' TD.
	Show oil. 7" - 3028' WOC.
3/14	T.D. 3060' 1850' oil.
3/21	600 acid. Testing.
3/27	Lans. 3009'
	7" - 3028'
	T.D. 3060'
	600 acid.
	Potential 499 bbls. plus 8% wtr.
	COMPLETED

Map No. 73 Sec. 9 Twp. 15 R. 13WWell No. 1 RoessnerPhillips

Company

Contractor

COMPLETED

C $S\frac{1}{2}$ NW SE

SECTION PLAT

		o	

990 Ft. from N. Line

_____ Ft. from S. Line

_____ Ft. from E. Line

660 Ft. from W. Line

CORALENA POOL

Location _____

Rig up _____

Drilling and Remarks:

*Lans 3009**7" @ 3025.**600 acid**Pump 499 + 8% W**P.D.*

RECORD

Cased _____ in., _____ ft.

Sand _____

Gas _____

Oil _____

Total Depth 3060

PRODUCTION

1st 24 hrs. Nat. _____

1st 24 hrs. after shot _____

Gas _____ Cu. Ft.

Dry Hole _____

Abandoned _____

Date

MAR 27 1940 19

S. J. LEWIS Scout

Russell **KANSAS**Map No. 73 Sec. 9 Twp. 15 R. 13WWell No. 1 RoesnerPhillips

Company

Contractor

FIRST REPORT**C S $\frac{1}{2}$ NW SE****SECTION PLAT**

990 Ft. from N. Line

Ft. from S. Line

Ft. from E. Line

660 Ft. from W. Line**CORALENA POOL**Location X

Rig up

Drilling and Remarks:

RECORD

Cased _____ in., _____ ft.

Sand _____

Gas _____

Oil _____

Total Depth _____

PRODUCTION

1st 24 hrs. Nat. _____

1st 24 hrs. after shot _____

Gas _____ Cu. Ft.

Dry Hole _____

Abandoned _____

Date

JAN 17 1940 19S. J. LEWIS Scout