

KANSAS

Form 51—5M—7-40—Palace


Russell

Section 9 Township 15 Range 13-W

Well No. #2 Roesner

Company Phillips

NORTH Coralena Pool

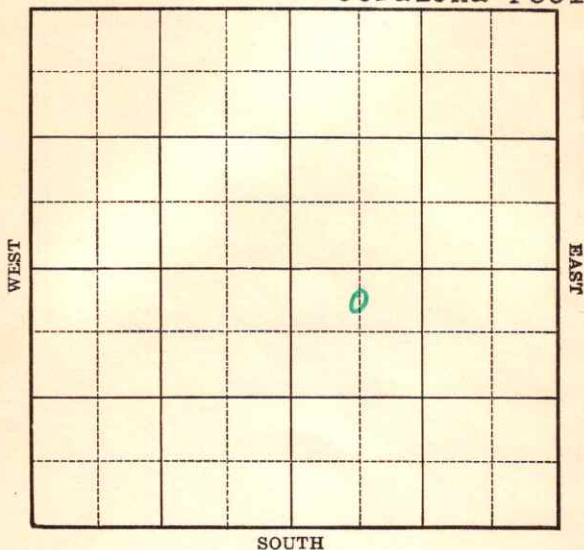

Sec. 9 Twp. 15 R. 13-WWell No. #2 Roesner FarmPhillips Company

(Coralena)


330 Ft. from N. Line

Ft. from S. Line

Ft. from E. Line

660 Ft. from W. Line

Elev. 1863

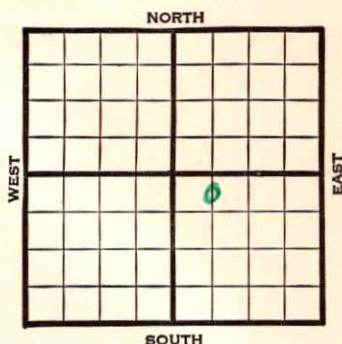

	REPORT
1940	
8/21	Location
8/28	Rotary.
9/5	"
9/12	1830' fsg. drill pipe.
9/19	10" - 604' Lans. 3014'
	Coring 3036'
9/26	7" - 3042' 3033' TD. RUST.
10/3	7" - 3033' (Corrected) RUST.
10/10	T.D. 3063' Flow 142 bbls. 6 $\frac{3}{4}$ hours.
10/17	" " "
10/24	" " "
10/30	Lans. 3014'
	7" - 3033'
	T.D. 3063'
	5000 acid.
	Potential 3293 bbls., flow.
	Maximum 3000 bbls.
	COMPLETED

Map No. 73 Sec. 9 Twp. 15 R. 13WWell No. 2 Roesner

Phillips

Company

Contractor

FIRST REPORT

C N L NW SE

330 Ft. from N. Line Ft. from S. Line Ft. from E. Line660 Ft. from W. Line

SECTION PLAT

		o	

CORALENA POOL

Location XRig up

Drilling and Remarks:

RECORD

Cased in., ft.Sand Gas Oil Total Depth

PRODUCTION

1st 24 hrs. Nat. 1st 24 hrs. after shot Gas Cu. Ft.Dry Hole Abandoned

Date

AUG 21 1940

19

S. J. LEWIS

Scout

Map No. 73 Sec. 9 Twp. 15 R. 13WWell No. 2 RoesnerPhillips Company

Contractor

COMPLETED

C N L NW SE

SECTION PLAT330 Ft. from N. Line Ft. from S. Line Ft. from E. Line660 Ft. from W. Line

		o	

CORALENA POOL

Location Rig up

Drilling and Remarks:

*Lease 3014**7" @ 3033**5000 acid**Flow 3293 Rx**May 3000***RECORD**Cased in., ft.Sand Gas Oil Total Depth 3063**PRODUCTION**1st 24 hrs. Nat. 1st 24 hrs. after shot Gas Cu. Ft.Dry Hole Abandoned

Date

OCT 30 1940 19 S. J. LEWIS Scout