

Section 5 Township 16 Range 10-W

Well No. ~~1 Adamek~~ # 3 Adamek "A"

Company ~~Bartlett et al~~ Grant Oil Co.


~~Semi-Wildcat~~

NORTH

WEST

EAST

SOUTH

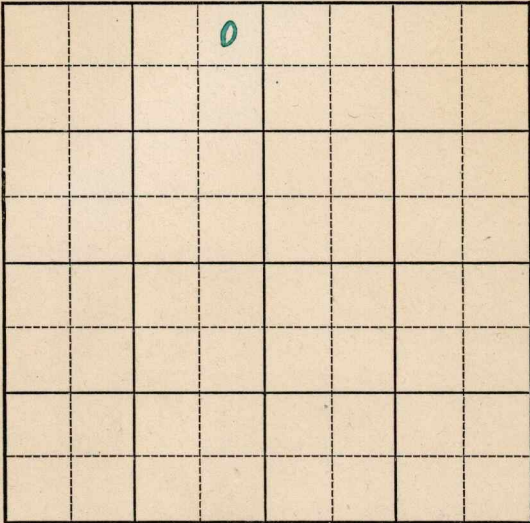



Map No. K-55 Sec. 5 Twp. 16 R. 10W

Well No. 1 Adamek OR 3 Adamen

Bartlett etal Grant Oil <sup>3 KGS/PM</sup> Company

Contractor

**FIRST REPORT**  
NE NW


330 Ft. from N. Line

\_\_\_\_\_ Ft. from S. Line

330 Ft. from E. Line

\_\_\_\_\_ Ft. from W. Line

**SECTION PLAT**

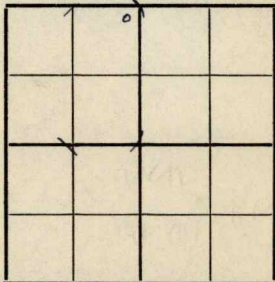

Semi WILDCAT

Location \_\_\_\_\_

Rig up \_\_\_\_\_

Drilling and Remarks:

**RECORD**

Cased \_\_\_\_\_ in., \_\_\_\_\_ ft.

Sand \_\_\_\_\_

Gas \_\_\_\_\_

Oil \_\_\_\_\_

Total Depth \_\_\_\_\_

**PRODUCTION**

1st 24 hrs. Nat. \_\_\_\_\_

1st 24 hrs. after shot \_\_\_\_\_

Gas \_\_\_\_\_ Cu. Ft.

Dry Hole \_\_\_\_\_

Abandoned \_\_\_\_\_

Date

OCT 1 1941

19

**S. J. LEWIS**

Scout

Map No. K-55 Sec. 5 Twp. 16 R. 10W

Well No. 1 Adamek or 3 Adamek KGS

Bartlett etal Grant Oil Company

**ABANDONED**

Contractor

NE NW

SECTION PLAT

330 Ft. from N. Line

\_\_\_\_\_ Ft. from S. Line

330 Ft. from E. Line

\_\_\_\_\_ Ft. from W. Line


SEMI WILDCAT

Location \_\_\_\_\_

Rig up \_\_\_\_\_

Drilling and Remarks:

*Cor & 3314*

*No show*

RECORD

Cased \_\_\_\_\_ in., \_\_\_\_\_ ft.

Sand \_\_\_\_\_

Gas \_\_\_\_\_

Oil \_\_\_\_\_

Total Depth 3355

PRODUCTION

1st 24 hrs. Nat. \_\_\_\_\_

1st 24 hrs. after shot \_\_\_\_\_

Gas \_\_\_\_\_ Cu. Ft.

Dry Hole \_\_\_\_\_

Abandoned \_\_\_\_\_

Date

OCT 29 1941

19

S. J. LEWIS

Scout

County Ellsworth Elev. 1791 DF  
 Sec. 5 Twp. 16 Rge. LOW  
 Company Grant Oil Co.  
 Farm Name Adamek "A" No. 3

TOPS		DEPTH	LOG	DATUM	Loc. in Sec.
Anh.	<u>Ft Riley</u>	<u>1555</u>			<u>NE NE NW</u>
T.P.					<u>(OWWO)</u>
H.P.	<u>Flint</u>	<u>1655</u>			
Tr.					
Dg.	<u>Wreford</u>	<u>1735</u>			
Bl.					
L.		<u>2957</u>			Geol.
K.C.					Contr. <u>Birmingham-</u>
B.K.C.					<u>Bartlett</u>
Ce.		<u>3280</u>			Pool
C.					<u>Stoltenberg</u>
M.					
M.					
K.					
Mz.					
Me.					
V.					
S.					
S.		<u>3310</u>			
A.					
R.					
Pf.					
G.					
T.D.		<u>3355</u>			<b>ABANDONED</b>



Date Comm. M I R T JUL 10 '57 CO 3355 Ran  
Log

*D E A*

Co.  
No.  
Sec.  
T.  
R.

O.W.W.O.

FORM 513 SUNRAY

County Ellsworth Elev. 1791 DF Co.  
 Sec. 5 Twp. 16 Rge. 10W  
 Company Grant Oil Co.  
 Farm Name Adamek "A" No. 3

IOPS	DEPTH	LOG	DATUM	Loc. in Sec.
Anh. <u>Ft Riley</u>	<u>1555</u>			<u>NE NE NW</u>
T.P.				<u>(OWWO)</u>
H. <u>Flint</u>	<u>1655</u>			
Tr.				
Dg. <u>Wreford</u>	<u>1735</u>			
Bl.				
L.	<u>2957</u>			Geol. _____
K.C.				Contr. <u>Birmingham</u>
B.K.C.				<u>Bartlett</u>
Ce.				Pool _____
C.	<u>3280</u>			<u>Stoltenberg</u>
M.				
M.				
K.				
Mz.				
Mq.				
V.				
S.				
S.				
A.	<u>3310</u>			FIRST REPORT
R.				
Pe.				<u>JUL 3 57</u>
G.				
T.D.	<u>3355</u>			

Date Comm. M I R T

12

Co.  
 Sec.  
 No.  
 Sec.  
 T.  
 R.