

KANSAS

Form 51—5M—7-40—Palace


Ellsworth

Section 5 Township 16 Range 10-W

Well No. #3 Haska

Company Magnolia


NORTH Stoltenberg Pool

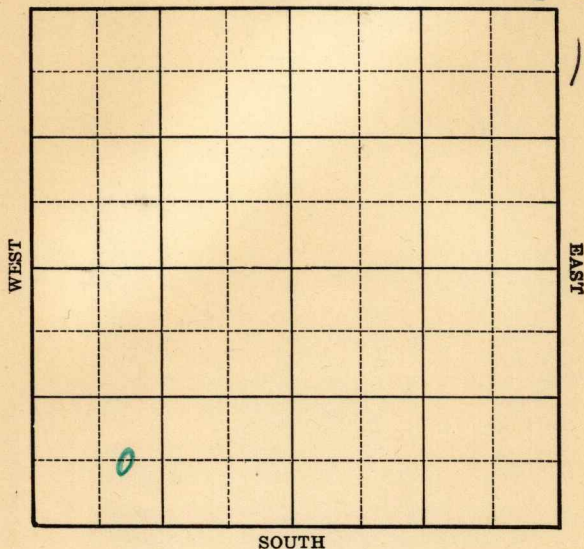

Sec. 5 Twp. 16 R. 10-WWell No. #3 Haska FarmMagnolia

Company

(Stollenberg)

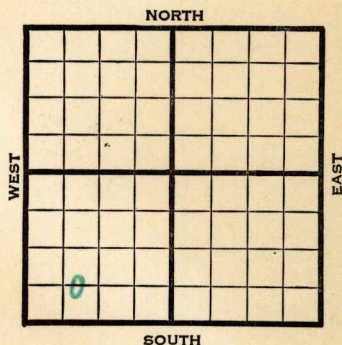 Ft. from N. Line660 Ft. from S. Line Ft. from E. Line990 Ft. from W. Line**Elev. 1788**

1940

REPORT

11/13 Derrick.

11/21 10" p 361' WOC.

11/27 Drlg. 2995'

12/5 **Lans. 2953' Arb. 3256-60' T.D.**

5" - 3260' RUST.

12/12 T.D. 3267' 1000 acid.

Swab 195 bbls. 7 hours.

12/18 **Arb. 3256'**

5" - 3260'

T.D. 3267'

1000 acid.

Echometer potential 1159 bbls.,

28% water.

Working potential 834 bbls.

44. Gravity

COMPLETED

Map No. 55 Sec. 5 Twp. 16 R. 10WWell No. 3 HaskaMagnolia Company

Contractor

FIRST REPORT

C E L S W S W

SECTION PLAT

 Ft. from N. Line660 Ft. from S. Line Ft. from E. Line990 Ft. from W. Line

STOLTENBERG POOL

Location Rig up

Drilling and Remarks:

Derrick

RECORD

Cased in., ft.Sand Gas Oil Total Depth

PRODUCTION

1st 24 hrs. Nat. 1st 24 hrs. after shot Gas Cu. Ft.Dry Hole Abandoned

Date

NOV 13 1940

19

S. J. LEWIS

Scout

Map No. 55 Sec. 5 Twp. 16 R. 10WWell No. 3 HaskaMagnolia Company

Contractor

COMPLETED

C E L SW SW

SECTION PLAT

 Ft. from N. Line660 Ft. from S. Line Ft. from E. Line990 Ft. from W. Line

STOLTENBERG POOL

Location Rig up

Drilling and Remarks:

*Cr & 3256**5" @ 3260**1000 acid**Echo. Pa & 1159**28% W.**Working Pa & 834**44° Gr.***RECORD**Cased in., ft.Sand Gas Oil Total Depth 3267**PRODUCTION**1st 24 hrs. Nat. 1st 24 hrs. after shot Gas Cu. Ft.Dry Hole Abandoned

Date

DEC 18 1940 19

S. J. LEWIS Scout