


Section 9 Township 15 Range 13-W

Well No. #3 Rosener

Company Stanolind

NORTH **Coralena Pool**

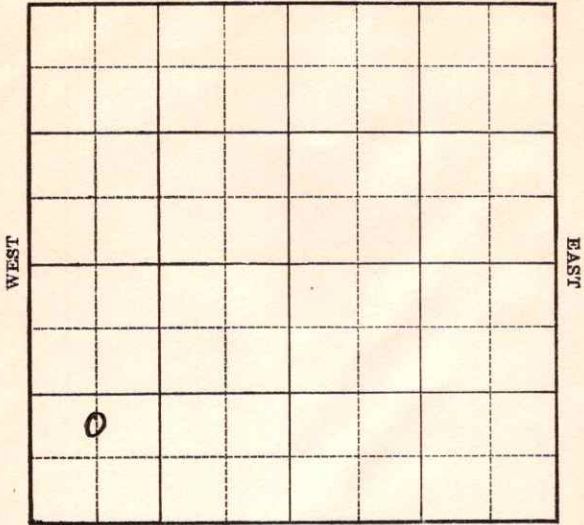

SOUTH

Sec. 9 Twp. 15 R. 13-W

Well No. #3 Rosener Farm  
Stanolind Company


(Coralena)

\_\_\_\_\_ Ft. from N. Line

990 Ft. from S. Line

\_\_\_\_\_ Ft. from E. Line

660 Ft. from W. Line

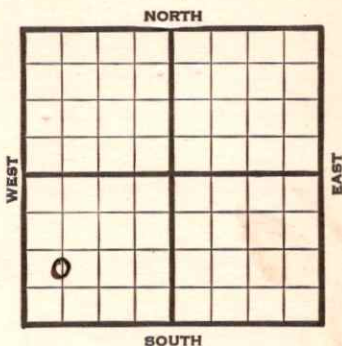

**Elev. 1873**

1939	REPORT
6/14	Location
6/23	"
6/29	Rigging up.
7/6	16" - 48' Drlg. 400'
7/13	<b>Anhy 838'</b> 10" - 831'
	Drlg. 930'
7/20	Drlg. 1178'
7/27	Drlg. 1915'
8/3	8 1/4" - 2245' Drlg. 2285'
8/10	8" - 2403' Drlg. 2830'
8/17	<b>Lans. 3042'</b> 7" - 3042'
	S.O. & G. 3060' T.D. 3064' WOC.
8/24	" " " " " "
8/31	" " " " " "
9/7	T.D. 3068' 2500' oil.
	4000 acid. No test.
	<b>OVER</b>

1939

9/13

Lans. 3042'

7" - 3042'

T.D. 3068'

4000 acid.

Potential 636 bbls., pump.

COMPLETED

Russell

Map No. \_\_\_\_\_ Sec. 9 Twp. 15 R. 13W

Well No. 3 Rosener

Stanolind Company

Contractor

FIRST REPORT

C N L SW SW

SECTION PLAT


\_\_\_\_\_ Ft. from N. Line

990 Ft. from S. Line

\_\_\_\_\_ Ft. from E. Line

660 Ft. from W. Line

CORALENA POOL

Location \_\_\_\_\_

Rig up \_\_\_\_\_

Drilling and Remarks:

**Loc.**

RECORD

Cased \_\_\_\_\_ in., \_\_\_\_\_ ft.

Sand \_\_\_\_\_

Gas \_\_\_\_\_

Oil \_\_\_\_\_

Total Depth \_\_\_\_\_

PRODUCTION

1st 24 hrs. Nat. \_\_\_\_\_

1st 24 hrs. after shot \_\_\_\_\_

Gas \_\_\_\_\_ Cu. Ft.

Dry Hole \_\_\_\_\_

Abandoned \_\_\_\_\_

Date

JUN 14 1939 19

S. J. LEWIS

Scout

Map No. \_\_\_\_\_ Sec. 9 Twp. 15 R. 13WWell No. 3 Rosener

Stanolind

Company

Contractor

COMPLETED

## SECTION PLAT

C N L SW SW

\_\_\_\_\_ Ft. from N. Line

990 Ft. from S. Line

\_\_\_\_\_ Ft. from E. Line

660 Ft. from W. Line

CORALENA POOL

o			

Location \_\_\_\_\_

Rig up \_\_\_\_\_

Drilling and Remarks:

*Case 3042.**7" @ 3042**4000 acq**Pump 636 P. X.*

## RECORD

Cased \_\_\_\_\_ in., \_\_\_\_\_ ft.

Sand \_\_\_\_\_

Gas \_\_\_\_\_

Oil \_\_\_\_\_

Total Depth 3068

## PRODUCTION

1st 24 hrs. Nat. \_\_\_\_\_

1st 24 hrs. after shot \_\_\_\_\_

Gas \_\_\_\_\_ Cu. Ft.

Dry Hole \_\_\_\_\_

Abandoned \_\_\_\_\_

Date

SEP 13 1939

19

S. J. LEWIS

Scout