

KANSAS

Form 51—5M—7-40—Palace


Ellsworth

Section 5 Township 16 Range 10-W

Well No. #3 Haska

Company Jayhawk Drilling

NORTH Stoltenberg Pool

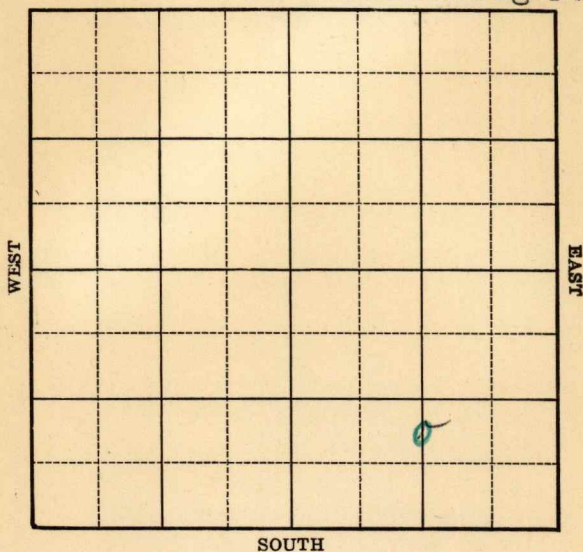


KANSAS

Ellsworth

Sec. 5 Twp. 16 R. 10-WWell No. #3 Haska FarmJayhawk Drlg. Company

(Stoltenberg)

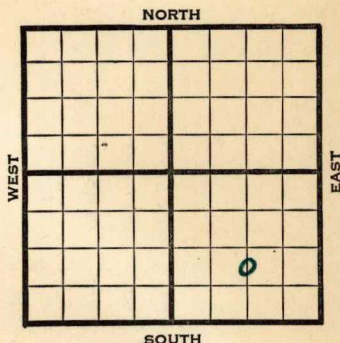 Ft. from N. Line990 Ft. from S. Line1320 Ft. from E. Line Ft. from W. Line

Elev. 1808

1940

REPORT

11/20

Location

11/27

Derrick.

12/5

10" - 284' Drlg. 1550'

12/12

Anhy. 690' Lans. 2958'

Drlg. 3059'

12/19

Arb. ^{3281'}~~3283'~~ 85' T.D. 5" - ^{3281'}~~3283'~~

RUST.

12/26

Arb. 3281' (Corrected)

5" - 3281' T.D. 3301'

125' oil 13½ hours.

500 acid. No inc.

T.D. 3305' No Inc.

12/30

Arb. 3281'

5" - 3281'

T.D. 3317½'

750 acid.

Potential 65 bbls., pump.

44. Gravity

COMPLETED

Map No. 55 Sec. 5 Twp. 16 R. 10 WWell No. 3 HaskaJayhawk Drilling Company


Contractor

FIRST REPORT

SECTION PLAT

C N L S $\frac{1}{2}$ SE Ft. from N. Line990 Ft. from S. Line1320 Ft. from E. Line Ft. from W. Line

STOLTENBERG POOL

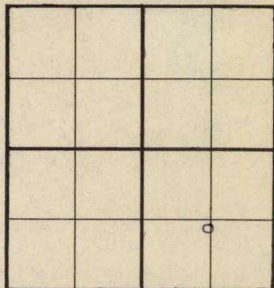Location XRig up

Drilling and Remarks:

RECORD

Cased in., ft.Sand Gas Oil Total Depth

PRODUCTION

1st 24 hrs. Nat. 1st 24 hrs. after shot Gas Cu. Ft.Dry Hole Abandoned

Date

NOV 20 1940 19 S. J. LEWIS Scout

KANSAS

Form 20-200 (Rev. 1-10-1916)

Map No. 25 Sec. 5 Twp. 10 R. 10

Please check range.

Company

Geological Dept.

Contractor

FIRST REPORT

SECTION PLAT

ft. from N. line

990 ft. from S. line

1280 ft. from E. line

ft. from W. line

STOTTENBERG POOL

RECORD

Location X

ft. Gas

Sand

Gas

Drilling and Remarks:

Misc. Small Maps

Cards

Tracing

France Map

Scarborough

Moody Map

Geological Dept.

Moody Flat Book

Date

NOV 20 1917

Map No. 55 Sec. 5 Twp. 16 R. 10WWell No. 3 Haska

Jayhawk Drilling

Company

Contractor

COMPLETED

C N L S $\frac{1}{2}$ SE


Ft. from N. Line

990 Ft. from S. Line1320 Ft. from E. Line

Ft. from W. Line

STOLTENBERG POOL

SECTION PLAT

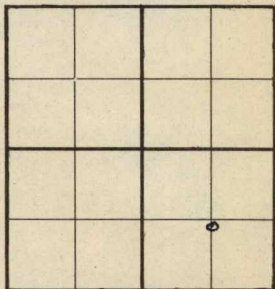

Location _____

Rig up _____

Drilling and Remarks:

*Core 3281**5" C 3281**750 Acid**Pump 65 x 4 1/2 Pk**44 c Gr.*

RECORD

Cased _____ in., _____ ft.

Sand _____

Gas _____

Oil _____

Total Depth 3317 1/2

PRODUCTION

1st 24 hrs. Nat. _____

1st 24 hrs. after shot _____

Gas _____ Cu. Ft.

Dry Hole _____

Abandoned _____

Date

DEC 30 1940

19

S. J. LEWIS

Scout