


Ellsworth

KANSAS

Section 5 Township 16 Range 10W

Well No. #3 Haska

Company Sohio et al

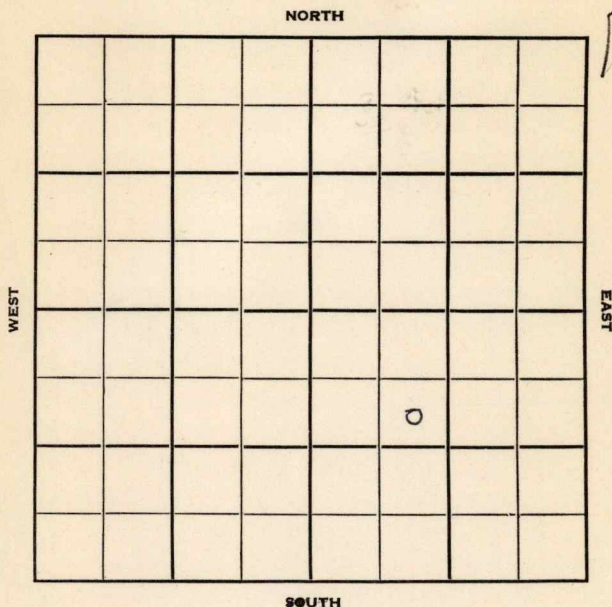

KANSAS

Ellsworth

Sec. 5 Twp. 16 R. 10W ✓

Well No. #3 Haska Farm

Sohio et al Company

Penguin Drlg. - Contr. Contractor

Stoltenberg Pool


990' Ft. from N. Line

 Ft. from S. Line

 Ft. from E. Line

990' Ft. from W. Line

SE NW SE

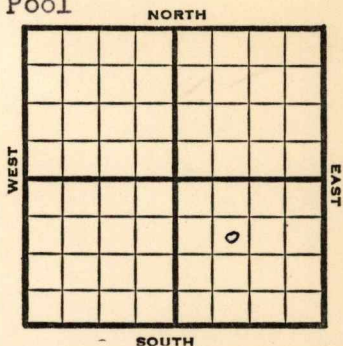

1950

Elev. 1838'

REPORT

12/6

MIM

12/27

Spud 12-6-50
Oil Well TD 3305
8" @ 316'

Heeb. 2866' Br Lime 2967

Lans. 2987'

DST 3077-3100 opn 1 hr

Rec. 90' mud & wtr

Arb. 3302-05

5" @ 3302 TD 3305

FU 1400' oil 30 min.

Comp. 3000 bopd

COMPLETED

County Ellsworth State Kansas

Sec. 5 (Blk. Twp.) 16 (Sur. Rge.) 10W Map No.

Operator Sohio etall

Well No. 3 Farm Haska

Elev.	Location	SE NW SE

990 Ft. From N Line SE

990 Ft. From **W** Line Quarter

1st. Report DEC 6 1950.

Completion

Remarks

Penguin Drlg. - Contr.


Spudding Date _____

Drig. Data Stoltenberg Pool

M I M

J. E. TYRA

County Ellsworth State Kansas
 Sec. 5 (Blk.) 16 (Sur.) 10W Map No.
 Operator Sohio etal.
 Well No. 3 Farm Haska
 Elev. 1838 Location SE NW SE

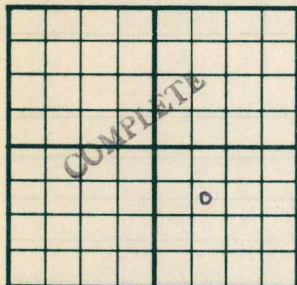

990 Ft. From N Line SE
990 Ft. From W Line Quarter

1st. Report

Completion DEC 27 1950

Remarks Stoltenberg Pool
Penguin Drlg. - Contr.

Spudding Date 12-6-50

Drlg. Data Oil well TD 3305
8" @ 316 Heeb. 2866 Br. lime 2967
Lans. 2987 DST 3077-3100 open 1 hr.
Rec. 90' mud & water Arb. 3302-05
5" @ 3302 TD 3305 FU 1400' oil 30 min.
Comp. 3000 bopd

J. E. TYRA