


Ellsworth

KANSAS

SECTION 5 TOWNSHIP 16S RANGE 10W

WELL NO. #5 Haska

COMPANY Sohio Petroleum

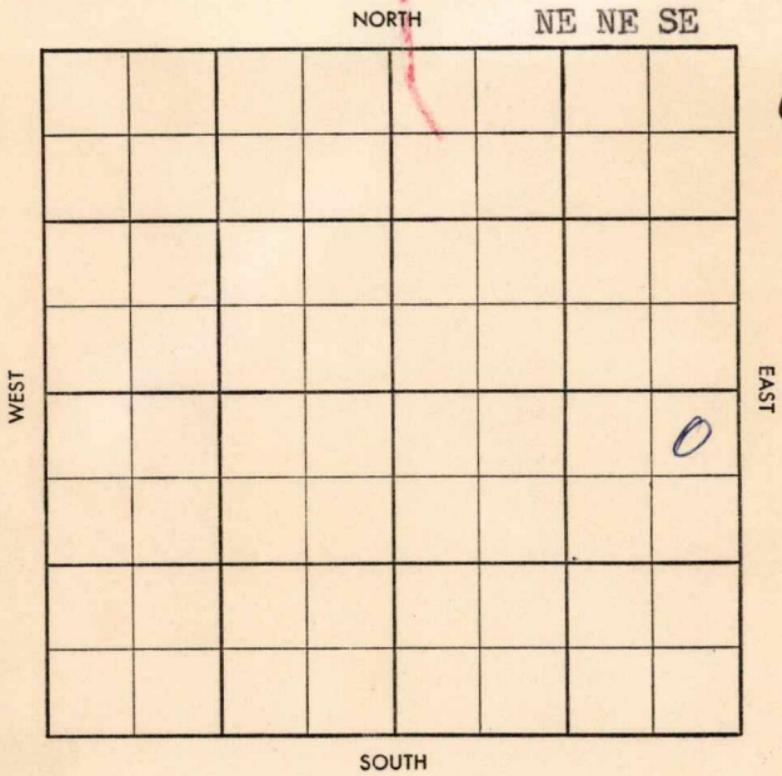

S-513-B

WILSON 12

County Ellsworth Elev. _____
 Sec. 5 Twp. 16 Rge. 10W
 Company Schio Petroleum
 Farm Name Haska No. 5

TOPS	DEPTH	LOG	DATUM
Anh.			
Tp.			
H.			
Tr.			
Dg.			
B. L.			
L.			
K.C.			
B.K.C.			
Ce.			
C.			
M.			
M.			
K.			
Mz.			
Mq.			
V.			
S.			
S.			
A.			
R.			
Pf.			
G.			
T.D.			

Loc. in Sec. NE NE SE

Geol. _____
Contr. Wilkerson

Pool Stoltenberg

FIRST REPORT
 MAR 12 1938

Date Comm. _____

WORT

Co.

Lsq.

No.

Sec.

T.

R.

Twp. ~~_____~~ Pool ~~_____~~
 Co. ~~_____~~ Facet ~~_____~~

S-513-B

County Ellsworth Elev. 1838 BF
 Sec. 5 Twp. 16 Rge. 1841 SW 10W
 Company Sohio Petroleum
 Farm Name Haska No. 5

TOPS	DEPTH	LOG	DATUM
Anh.			
Tp.			
H.	<u>2963</u>		
Tr.	<u>2882</u>		
Dg.			
B.L.	<u>2963</u>		
L.	<u>2978</u>		
K.C. <u>RLG</u>	<u>3278</u>		
B.K.C.			
Ce.			
C.			
M.			
M.			
K.			
Mz.			
Mq.			
V.			
S.	<u>3295</u>		
S.			
A.	<u>3320</u>		
R.			
Pf.			
G.			
T.D.	<u>3322</u>		

Loc. in Sec. NE NE SE

Geol. _____
 Contr. Wilkerson
 Pool Stoltenberg

COMPLETE
 APR 30 '58

Date Comin. 4-3-58

WORT MAR 19 '58 MAR 26 '58 APR 2 '58 APR 6 '58 Ø 27 1/3
APR 16 '58 8" 649 in log 5-3322
APR 23 '58 CO 3323 FU 800' oil
NW \$90.75 BO NW 2 hrs 140"
T&R top of APR 30 '58 P 280 Bopd
NW
P 25 Bopd NW
arb 3322-23

Log
No.
Sec.
T.
R.