

KANSAS


Ellsworth

FORM 51 5M PETROL

Section 5 Township 16 Range 10W

Well No. 4 Haska

Company Magnolia

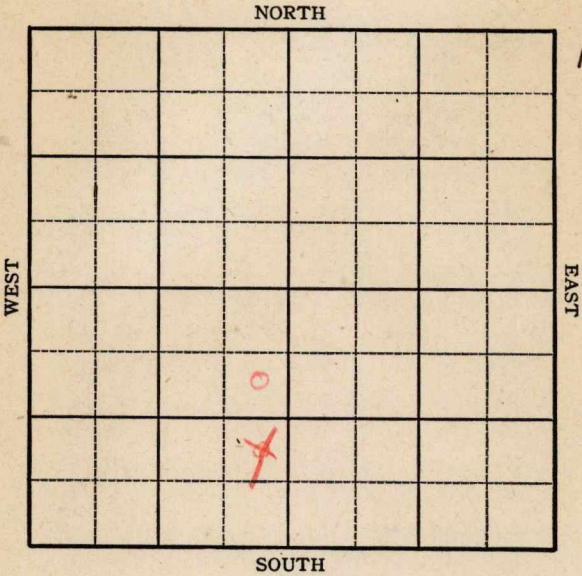

KANSAS

Ellsworth

Sec. 5 Twp. 16 R. 10-W

Well No. #4 Haska Farm


Magnolia Company

990 Ft. from N. Line

~~990~~ Ft. from S. Line

330 Ft. from E. Line

_____ Ft. from W. Line

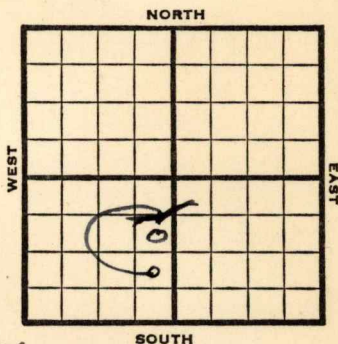

NE SE SW SE NE SW

1945 **Elev. 1815** REPORT

11/21	RUR
11/28	8" @ 402 Drlg. 500
12/5	Drlg. 2750'
12/12	Lans 2950 Arb. 3281 TD 3284 5" @ 3283 RUST
12/20	T.D. 3289' 1000 acid. Pump $2\frac{1}{2}$ oil per hr 24 hours.
12/28	Arb. 3281 5" @ 3283 1000 acid. TD 3289 Pump 81 Pot. Grav. 42.0

COMPLETED

KANSASKansas Pool Name StoltenbergMap No. 55 Sec. 5 Twp. 16 R. 10WWell No. 4 HaskaMagnolia Company**FIRST REPORT**

Contractor

NE SE SW

SECTION PLAT Ft. from N. Line990 Ft. from S. Line330 Ft. from E. Line Ft. from W. Line

Ellsworth CountyLocation Rig up

Drilling and Remarks:

RUR**RECORD**Cased in., ft.Sand Gas Oil Total Depth **PRODUCTION**1st 24 hrs. Nat. 1st 24 hrs. after shot Gas Cu. Ft.Dry Hole Abandoned

Date

NOV 21 1945 1945S. J. LEWIS Scout

KANSAS Pool Name Stoltenberg
 Map No. 5-8 Sec. 5 Twp. 16 R. 10W

Well No. 4 Haska

Magnolia

Company

CORRECTION

Contractor

SE NE SW


SECTION PLAT

990 Ft. from N. Line

 Ft. from S. Line

330 Ft. from E. Line

 Ft. from W. Line

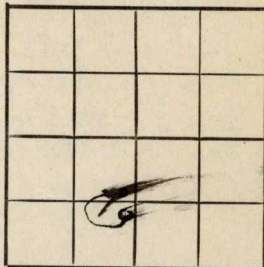

Ellsworth County

Location

Rig up

Drilling and Remarks:
reported

NE SE SW

RECORD

Cased in., ft.

Sand

Gas

Oil

Total Depth

PRODUCTION

1st 24 hrs. Nat.

1st 24 hrs. after shot

Gas Cu. Ft.

Dry Hole

Abandoned

Date

NOV 28 1945

19

S. J. LEWIS

Scout

KANSAS

Kansas

Pool Name Stoltenberg PoolMap No. K-55 Sec. 5 Twp. 16 R. 10WWell No. 4 HaskaMagnolia

Company

COMPLETED

Contractor


SE NE SW

EH 1815**SECTION PLAT**990 Ft. from N. Line

Ft. from S. Line

330 Ft. from E. Line

Ft. from W. Line

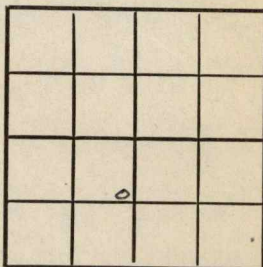Ellsworth County

Location

Rig up

Drilling and Remarks:

Cer 8 32815" @ 328310000 aditPump 51 Pot42 e gr**RECORD**

Cased _____ in., _____ ft.

Sand _____

Gas _____

Oil _____

Total Depth 3289**PRODUCTION**

1st 24 hrs. Nat. _____

1st 24 hrs. after shot _____

Gas _____ Cu. Ft.

Dry Hole _____

Abandoned _____

Date

DEC 2 8 1945

19

S. J. LEWIS

Scout