

KANSAS

Ellsowrth county

Section 6 Township 16 Range 10-WWell No. #1, CurnaCompany Derby et al

NORTH

SOUTH

WEST

EAST

14

0

KANSAS

Ellsworth County

Sec. 6 Twp. 16 R. 10W

Well No. #1 Curna Farm

Derby Etal

Company

Bloomer


Ft. from N. Line

330 Ft. from S. Line

Ft. from E. Line

330 Ft. from W. Line

SW SE

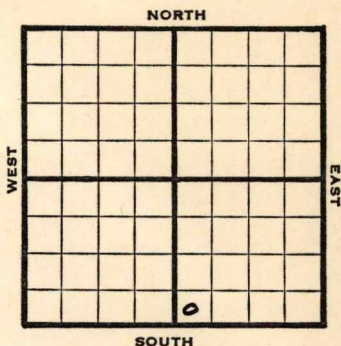

1946

1838

REPORT

9/25	Location		
10/1	"		
10/8	8" @ 370'		
	Drlg 2887'		
10/15	Lans 2904		
	Arb 3317'		
	TD3322		
	5" @ 3317 RUST		
10/22	TD3336'		
	3000 acid, swb 6½ oil in 9 hrs		
10/29	"	"	"
11/6	"	"	"
11/12	"	"	"
11/20	"	"	"
11/27	Arb 3317'		
	5" @ 3317'		
	TD 3336'		
	3000 Acid		
	Pump 133 POT		
	42 Grav.		

COMPLETED

KANSASKansas Pool Name BloomerMap No. 55 Sec. 6 Twp. 16 R. 10WWell No. 1 CurnaDerby Etal. Company**FIRST REPORT**

Contractor

SW SE

SECTION PLAT

 Ft. from N. Line330 Ft. from S. Line Ft. from E. Line330 Ft. from W. LineEllsworth CountyLocation XRig up

Drilling and Remarks:

RECORDCased in., ft.Sand Gas Oil Total Depth **PRODUCTION**1st 24 hrs. Nat. 1st 24 hrs. after shot Gas Cu. Ft.Dry Hole Abandoned

Date

SEP 25 1946 19S. J. LEWIS Scout

Map No. 55 Sec. 6 Twp. 16 R. 10W

Well No. 1 Curna

Derby etal. Company

COMPLETED

Contractor

SW SE

E. 1. 1887


SECTION PLAT

 Ft. from N. Line

330 Ft. from S. Line

 Ft. from E. Line

330 Ft. from W. Line

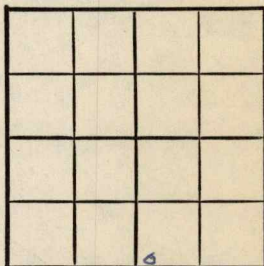

Ellsworth County

RECORD

Location

Rig up

Drilling and Remarks:

Ar 8317
5" 08817
3000 acid
Pump 133 ft

42° 24'

Cased in., ft.

Sand

Gas

Oil

Total Depth 8336

PRODUCTION

1st 24 hrs. Nat.

1st 24 hrs. after shot

Gas Cu. Ft.

Dry Hole

Abandoned

Date

NOV 27 1946

19

S. J. LEWIS

Scout