

KANSAS

Form 51-5M-7-39-Palace


Russell

Section 9 Township 15 Range 13-W

Well No. 10 Roesner

Company Stanolind

NORTH Coralena Pool

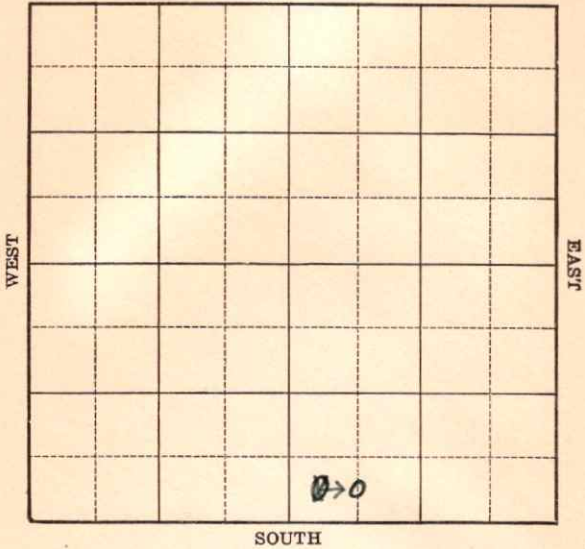

Sec. 9 Twp. 15 R. 13-W

Well No. #10 Roesner Farm

Stanolind

Company

(Caralena)


_____ Ft. from N. Line

330 Ft. from S. Line

_____ Ft. from E. Line

~~330~~ 660 Ft. from W. Line

Elev. 1839

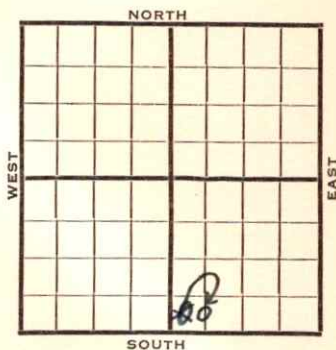

1940	REPORT
5/29	Cellar.
6/6	10" - 616' WOC.
6/13	Anhy 802' Drlg. 2230'
6/20	Topeka 2719' SO 2972-74'
	Lans. 3024' SO 3052-73'
	SO 3099-3119' Drlg.
6/27	B.K.C. 3290' Cong. 3308'
	7" - 3051' T.D. 3350' RUST.
7/2	Lans. 3024'
	7" - 3051'
	T.D. 3350'
	Cong. 3308'
	P.B. to 3080'
	5500 acid,
	Pump 933 oil, 10% water.
	COMPLETED

Map No. 73 Sec. 9 Twp. 15 R. 13WWell No. 10 RoesnerStanolind

Company

CORRECTION

Contractor

C S L SW SE

SECTION PLAT

		o	

 Ft. from N. Line330 Ft. from S. Line Ft. from E. Line660 Ft. from W. Line

CORALENA POOL

Location Rig up

Drilling and Remarks:

Reported

SW SE

RECORD

Cased in., ft.Sand Gas Oil Total Depth

PRODUCTION

1st 24 hrs. Nat. 1st 24 hrs. after shot Gas Cu. Ft.Dry Hole Abandoned

Date

JUN 13 1940 19S. J. LEWIS Scout

Map No. 73 Sec. 9 Twp. 15 R. 13WWell No. 10 Stanolind RoesnerStanolind Company

Contractor

COMPLETED

C S L SW SE

 Ft. from N. Line330 Ft. from S. Line Ft. from E. Line660 Ft. from W. Line

CORALENA POOL

SECTION PLAT

Location Rig up

Drilling and Remarks:

*Lease 3024**7" C 3051**Comp 3308**P.B 3080**5500 acid**Pump. 933 oil 10% water*

RECORD

Cased in., ft.Sand Gas Oil Total Depth 3350

PRODUCTION

1st 24 hrs. Nat. 1st 24 hrs. after shot Gas Cu. Ft.Dry Hole Abandoned

Date

JUL 2 1940 19S. J. LEWIS Scout