

KANSAS

Form 51-5M-7-40-Palace

Russell


O.W.P.B.

Section 9 Township 15 Range 13-W

Well No. #11 Roesner

Company Stanolind

NORTH Coralena Pool

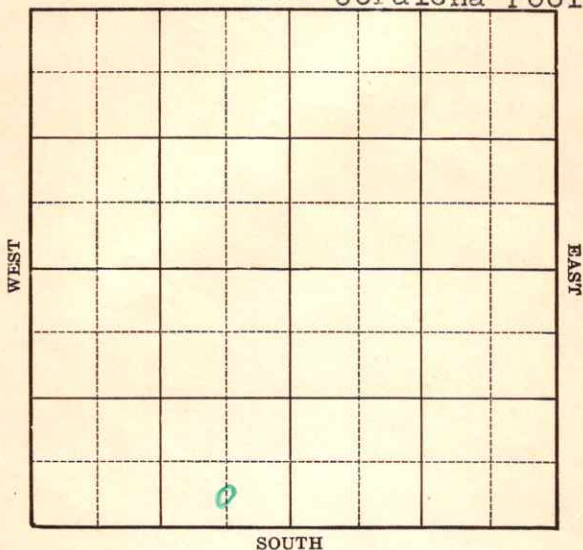



O. W. P. B.

Sec. 9 Twp. 15 R. 13-W

Well No. #11 Roesner Farm

Stanolind Company


(Coralena)

_____ Ft. from N. Line

330 Ft. from S. Line

660 Ft. from E. Line

_____ Ft. from W. Line

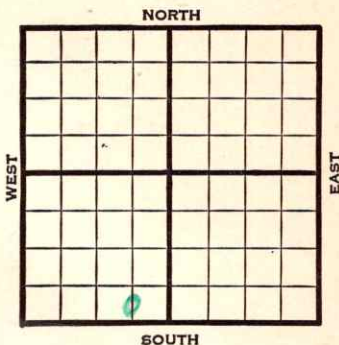

CSLSESW

Elev. 1867

1940	REPORT
10/30	Location
11/7	Derrick.
11/14	10" - 623' WOC.
11/21	Anhy 830' Drlg. 2175'
11/27	Tarkio 2400' Topeka 2764'
	Dodge 2995' Lans. 3030'
	SO 3049-50' Coring 3064'
12/5	Arb. 3325-61' T.D.
	7" - 3331' RUST. SSO.
12/12	" " " "
12/18	Arb. 3325'
	Lans. 3037'
	7" - 3331'
	T.D. 3361'
	Ripped csg. 3066-92'
	5000 acid.
	Potential 349 bbls., pump.
	38.2 Gravity
	COMPLETED
	OVER

1952
12/17

O. W. P. B.

Oil well TD 3361' Tarkio 2400'
Top 2764' Dodge 2995' OTD 3361'
7" @ 3331 PB 2495 20/2414-19
D-hydro. B/3/4 BO 1/4 BWPB
16/2403-07 Hydro 500 A
Comp. 3½ BOPD 4 BW

FIRST REPORT

COMPLETED

Map No. _____ Sec. 9 Twp. 15 R. 13W

Well No. 1 Roesner

Stanolind Company

FIRST REPORT Contractor

C S L SE SW

SECTION PLAT

_____ Ft. from N. Line

330 Ft. from S. Line

660 Ft. from E. Line

_____ Ft. from W. Line

CORALENA POOL

Location X

RECORD

Cased _____ in., _____ ft.

Sand _____

Gas _____

Oil _____

Total Depth _____

Rig up _____

Drilling and Remarks:

PRODUCTION

1st 24 hrs. Nat. _____

1st 24 hrs. after shot _____

Gas _____ Cu. Ft.

Dry Hole _____

Abandoned _____

Date

OCT 30 1940

S. J. LEWIS Scout

Sandy: Is #1 the correct well #?
We show several wells in SW/4.

Don.



Well No. 1
850
850
14 from W. line

RECORD

- Misc. Small Maps *AMS*
- Cards *AMS*
- Tracing *AMS*
- France Map *AMS*
- Scarborough Map *AMS*
- Moody Map *AMS*
- Geological Dept.
- Moody Flat Book

Map No. 73 Sec. 9 Twp. 15 R. 13WWell No. 11 RoesnerStanolind Company

Contractor

COMPLETED

SECTION PLAT

C S L SE SW

 Ft. from N. Line330 Ft. from S. Line660 Ft. from E. Line Ft. from W. Line

CORALENA POOL

Location Rig up

Drilling and Remarks:

*Cr 43825**Leane 3087**7" C 3381**Ripped cog. 3066-92**5000 acd**Pump 349 P.Y.**38.2 hrs.*

RECORD

Cased in., ft.Sand Gas Oil Total Depth 3361

PRODUCTION

1st 24 hrs. Nat. 1st 24 hrs. after shot Gas Cu. Ft.Dry Hole Abandoned

Date

DEC 18 1940 19

S. J. LEWIS Scout

O. W. P. B.

FORM 275 FOR SALE BY KANSAS BLUE PRINT CO

County **Russell** State **Kansas**Sec. **9** (Blk. Twp.) **15** (Sur. Rge.) **13W** Map No.Operator **Stanolind**Well No. **11** Farm **R. Roesner**Elev. **1867** Location **C S L SE SW**

FIRST REPORT
COMPLETE

330 Ft. From **S** Line **SW****660** Ft. From **E** Line Quarter1st. Report **DEC 17 1952**Completion **DEC 17 1952**Remarks **OWPB****O. W. P. B.**

Spudding Date

Drig. Data **Oil well TD 3361****Tarkio 2400 Top. 2764 Dodge 2995****OTD 3361 7" @ 3331 PB 2495 20/ 2414-19****D-hydro. B/ 3/4 bo 1/4 bwph 16/ 2403-07****Hydro. 500 A Comp. 3 1/2 bopd 4 bw**